


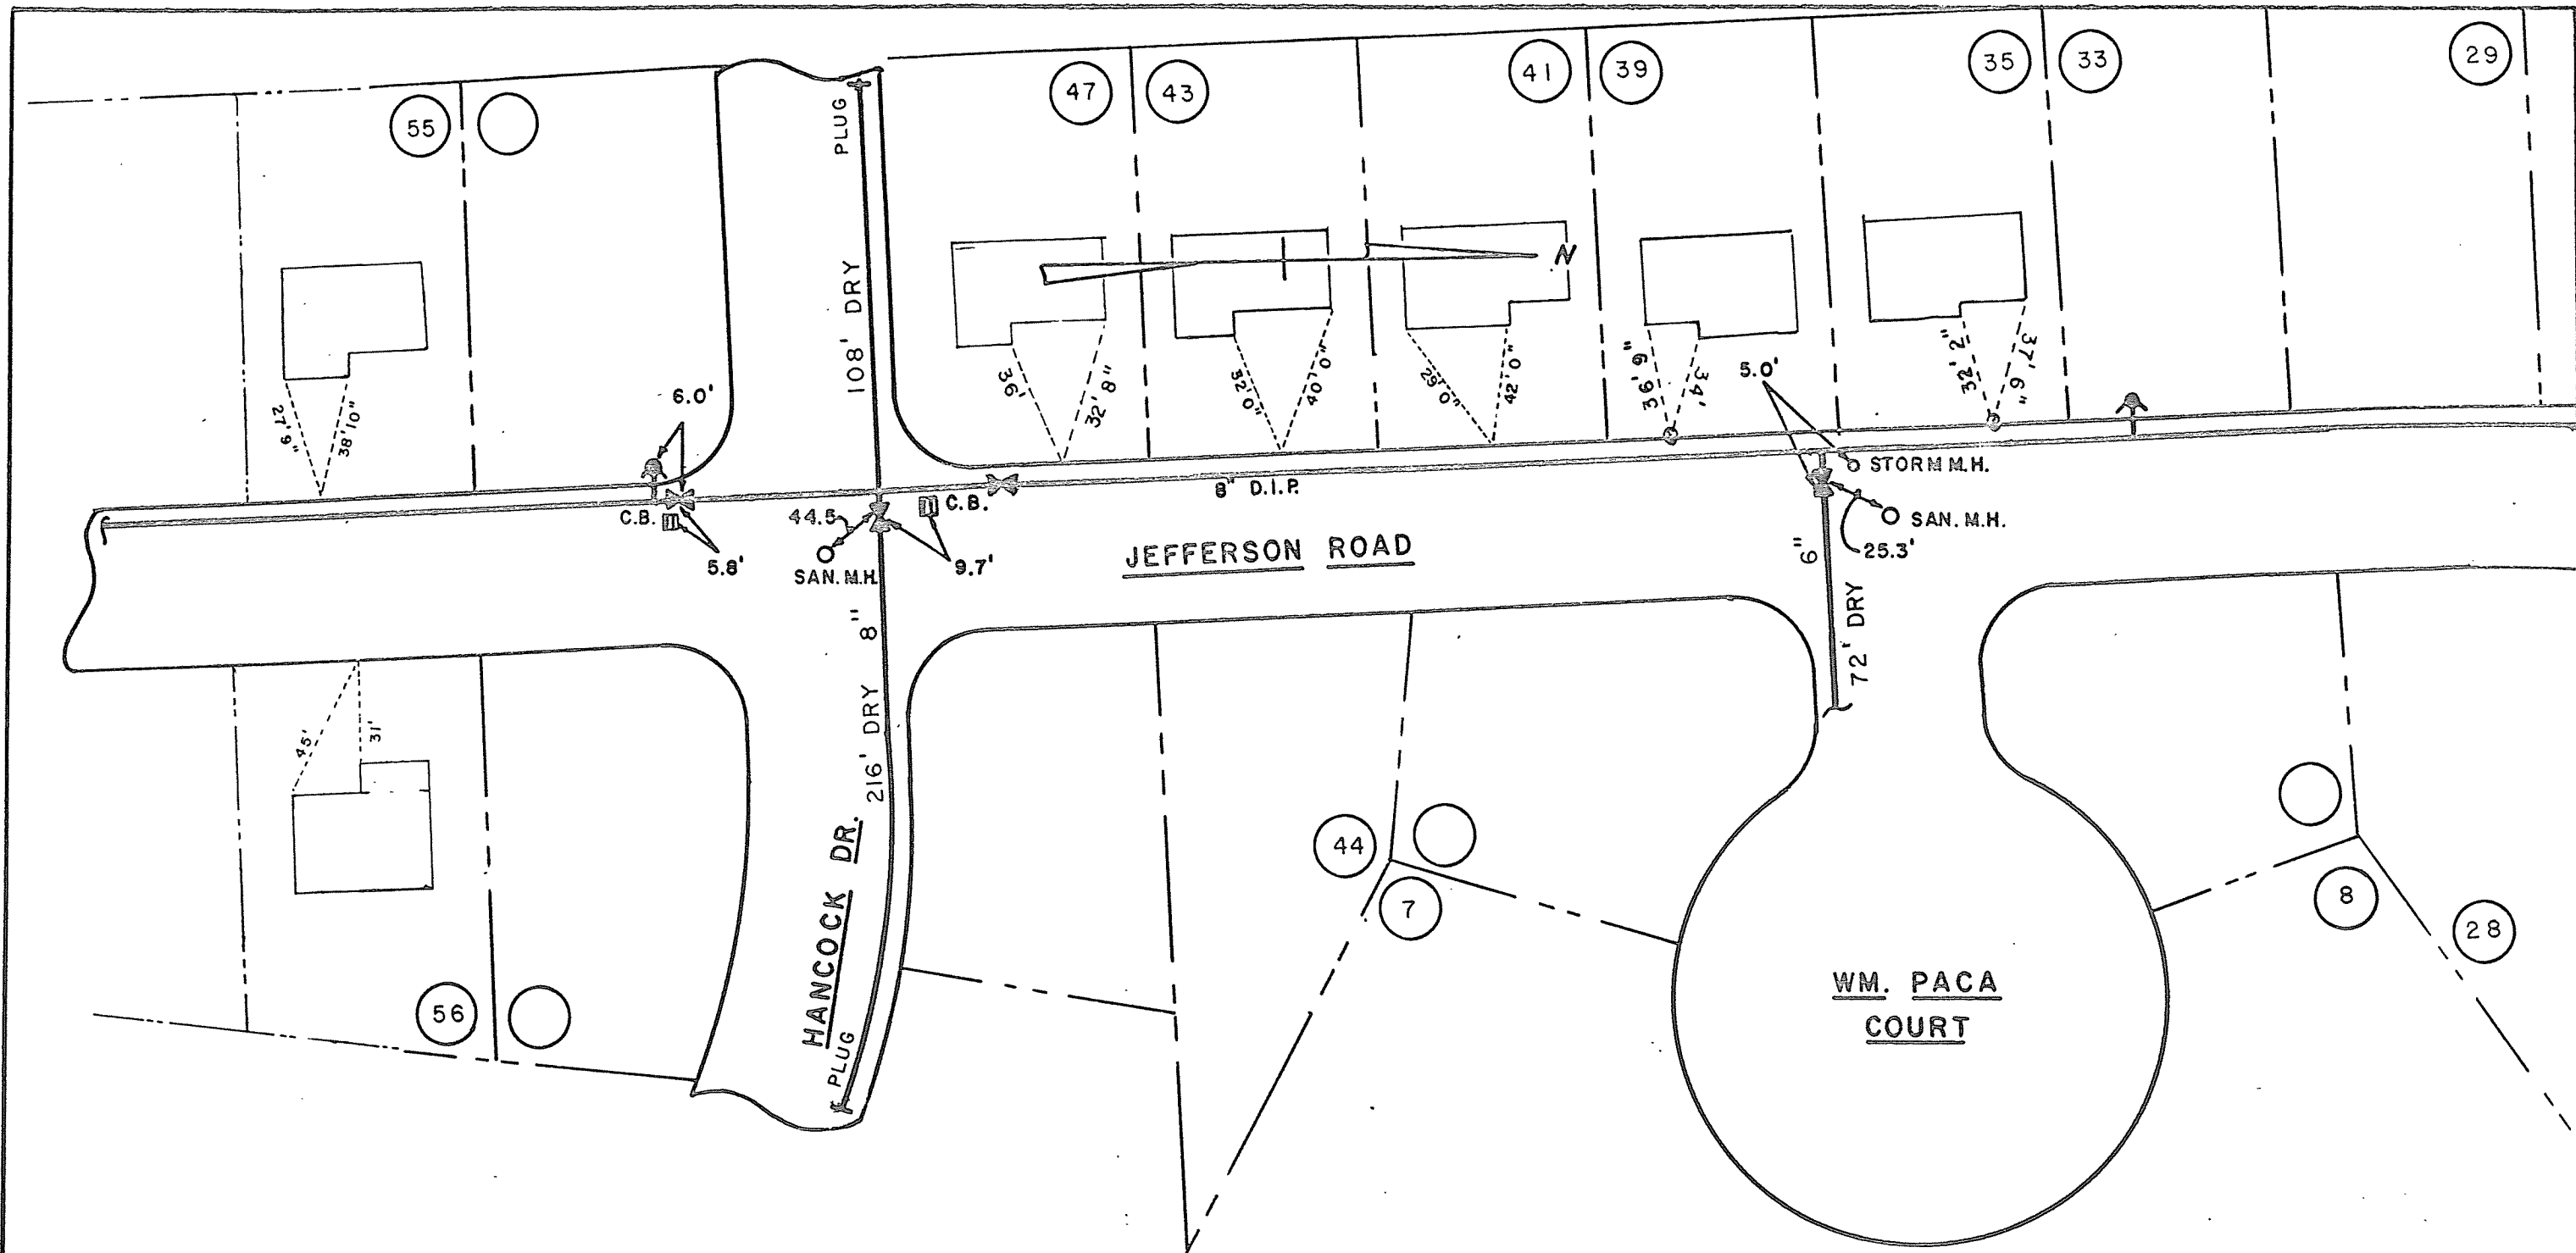

WM. PACA COURT

WM. PACA COURT
HANCOCK DR.
JEFFERSON ROAD

"BICENTENNIAL WOODS"

WATER DISTRICT NO. 1
TOWN OF BETHLEHEM

RECORD OF INSTALLATIONS
J. KENNETH FRASER & ASSOCIATES, P.C.

DWN. BY H.P.J.
CHK BY W.T.B.

CONSULTING ENGINEERS, RENSSELAER, N.Y.
SCALE 1"=50' OCTOBER 1980