


JEFFERSON

ROAD

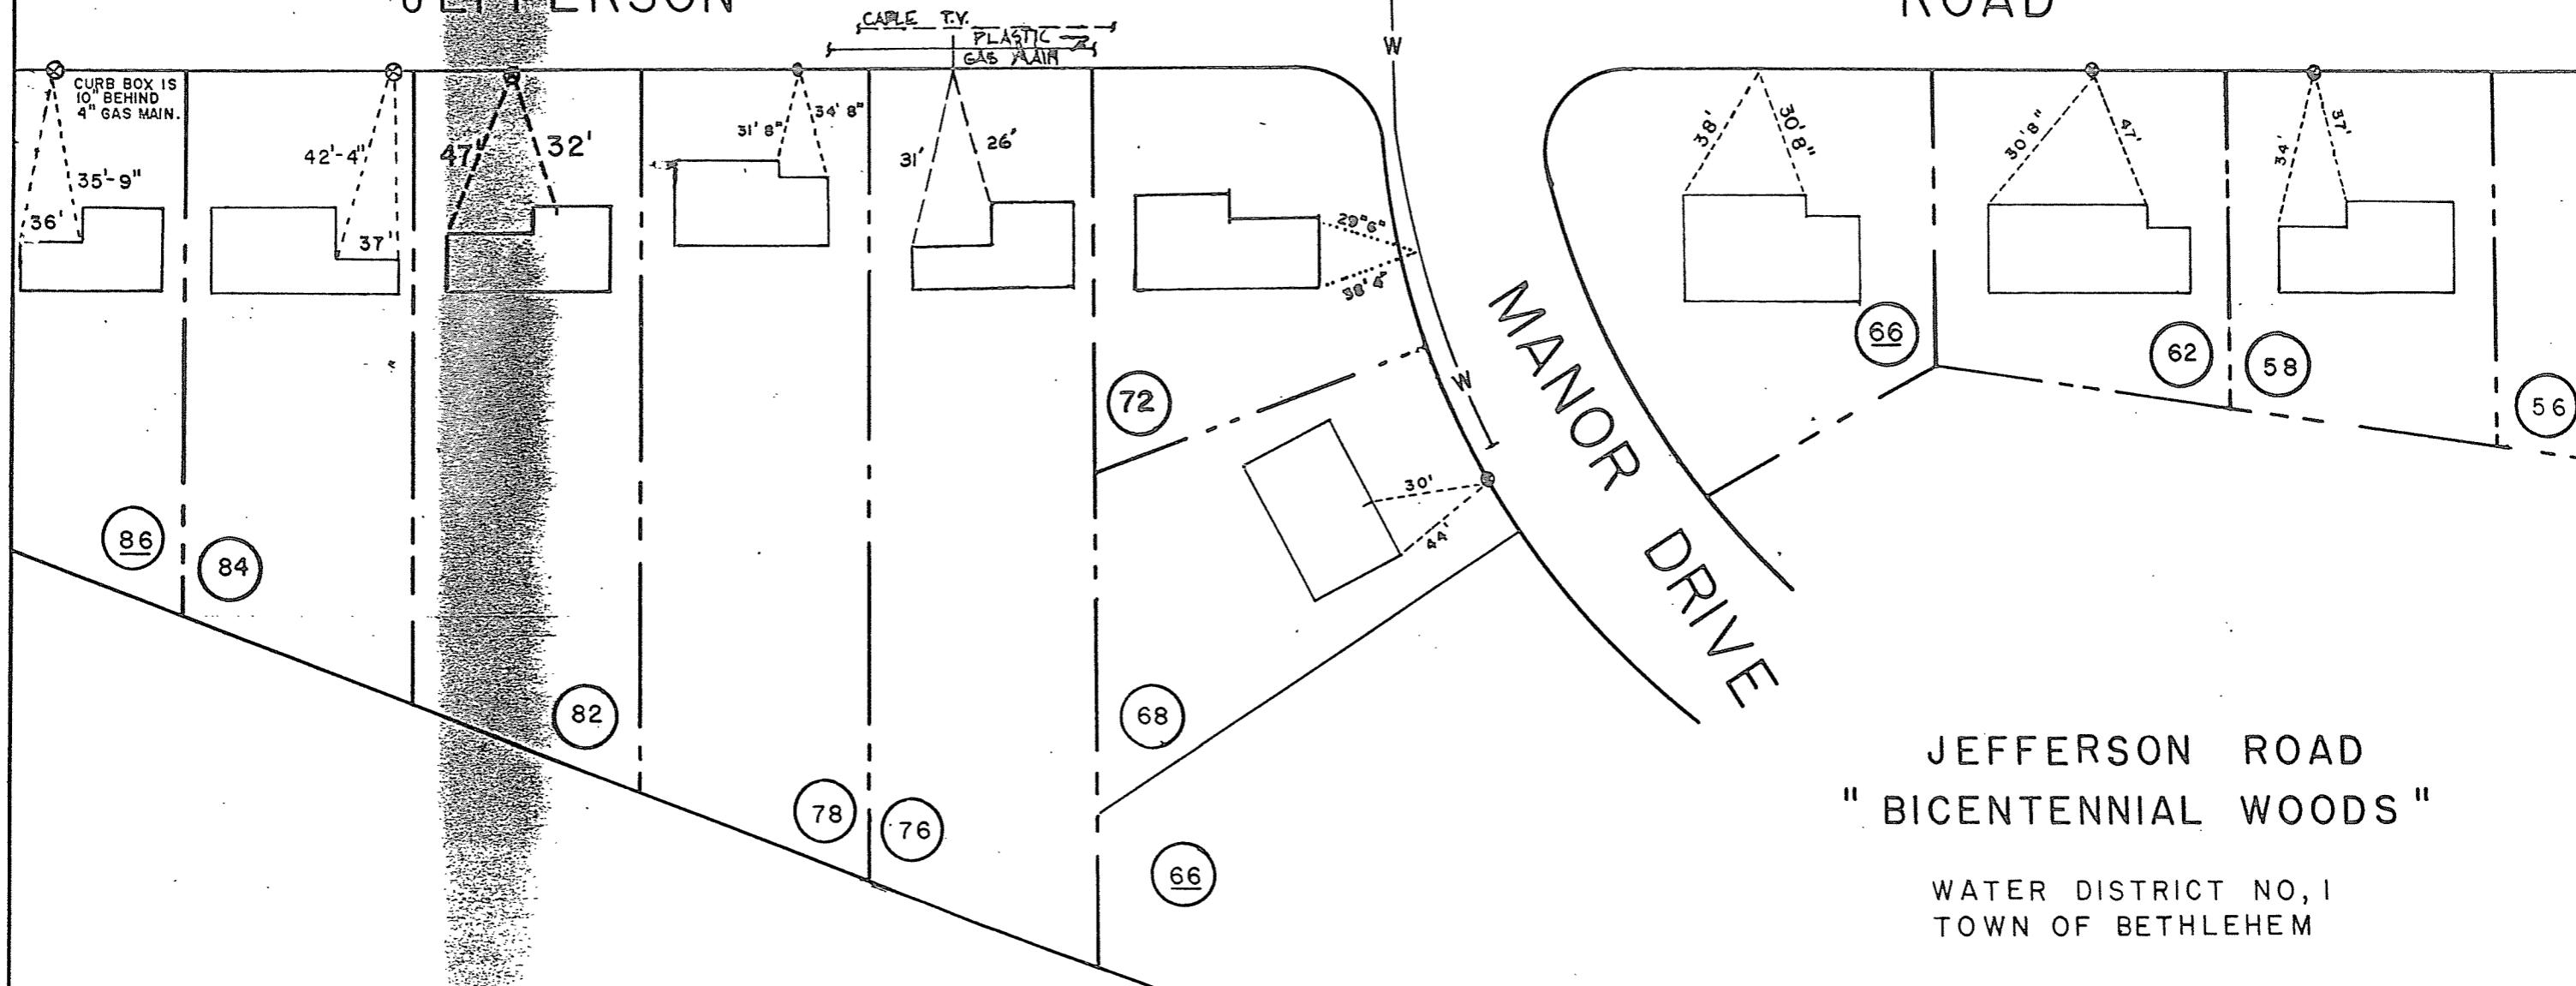

JEFFERSON ROAD
"BICENTENNIAL WOODS"

WATER DISTRICT NO. 1
TOWN OF BETHLEHEM

RECORD OF INSTALLATION
TOWN OF BETHLEHEM ENGINEERING
SCALE 1"-50'
JANUARY, 1981

DWN BY C.A.W.