



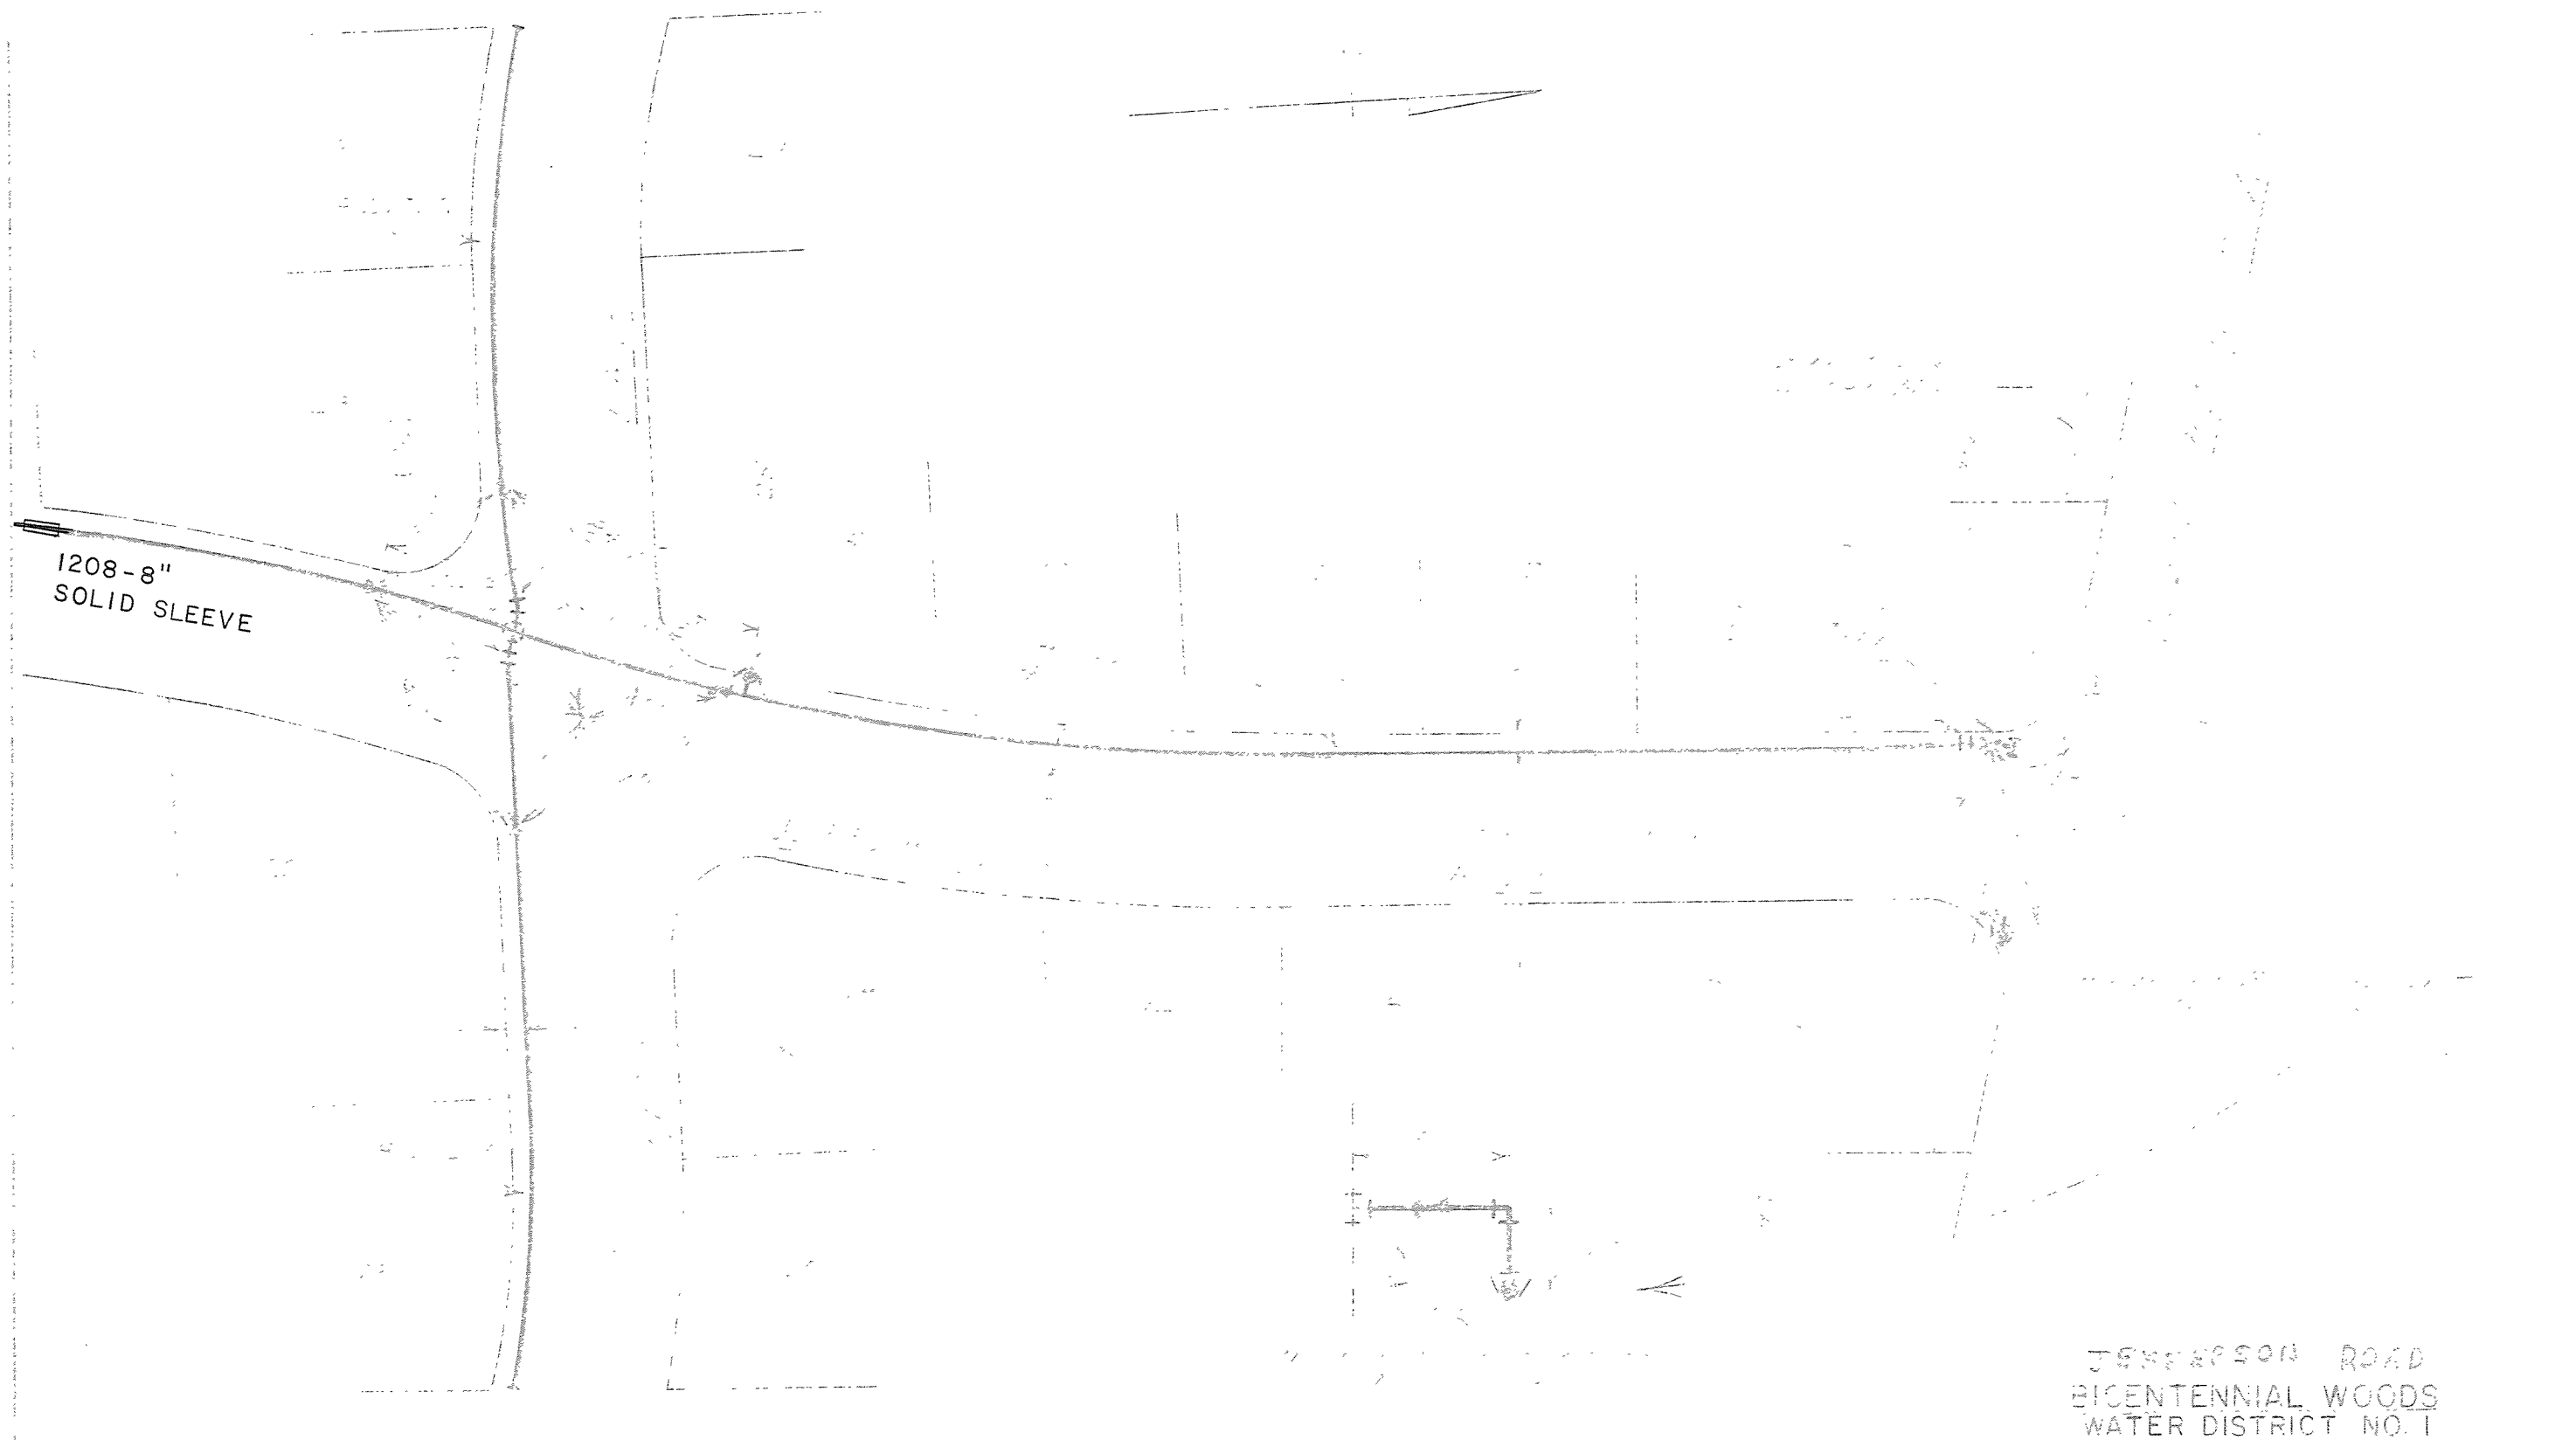

JENKINSON ROAD
BICENTENNIAL WOODS
WATER DISTRICT NO. 1
TOWN OF BETHLEHEM

RECORD OF INSTALLATIONS
J KENNETH FRASER & ASSOCIATES, PC
CONSULTING ENGRS RENSSELAER, NY
SCALE 1"=50' DECEMBER, 1976

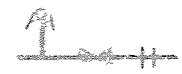

DWG. NO. 100-2
CHKD BY JTB