


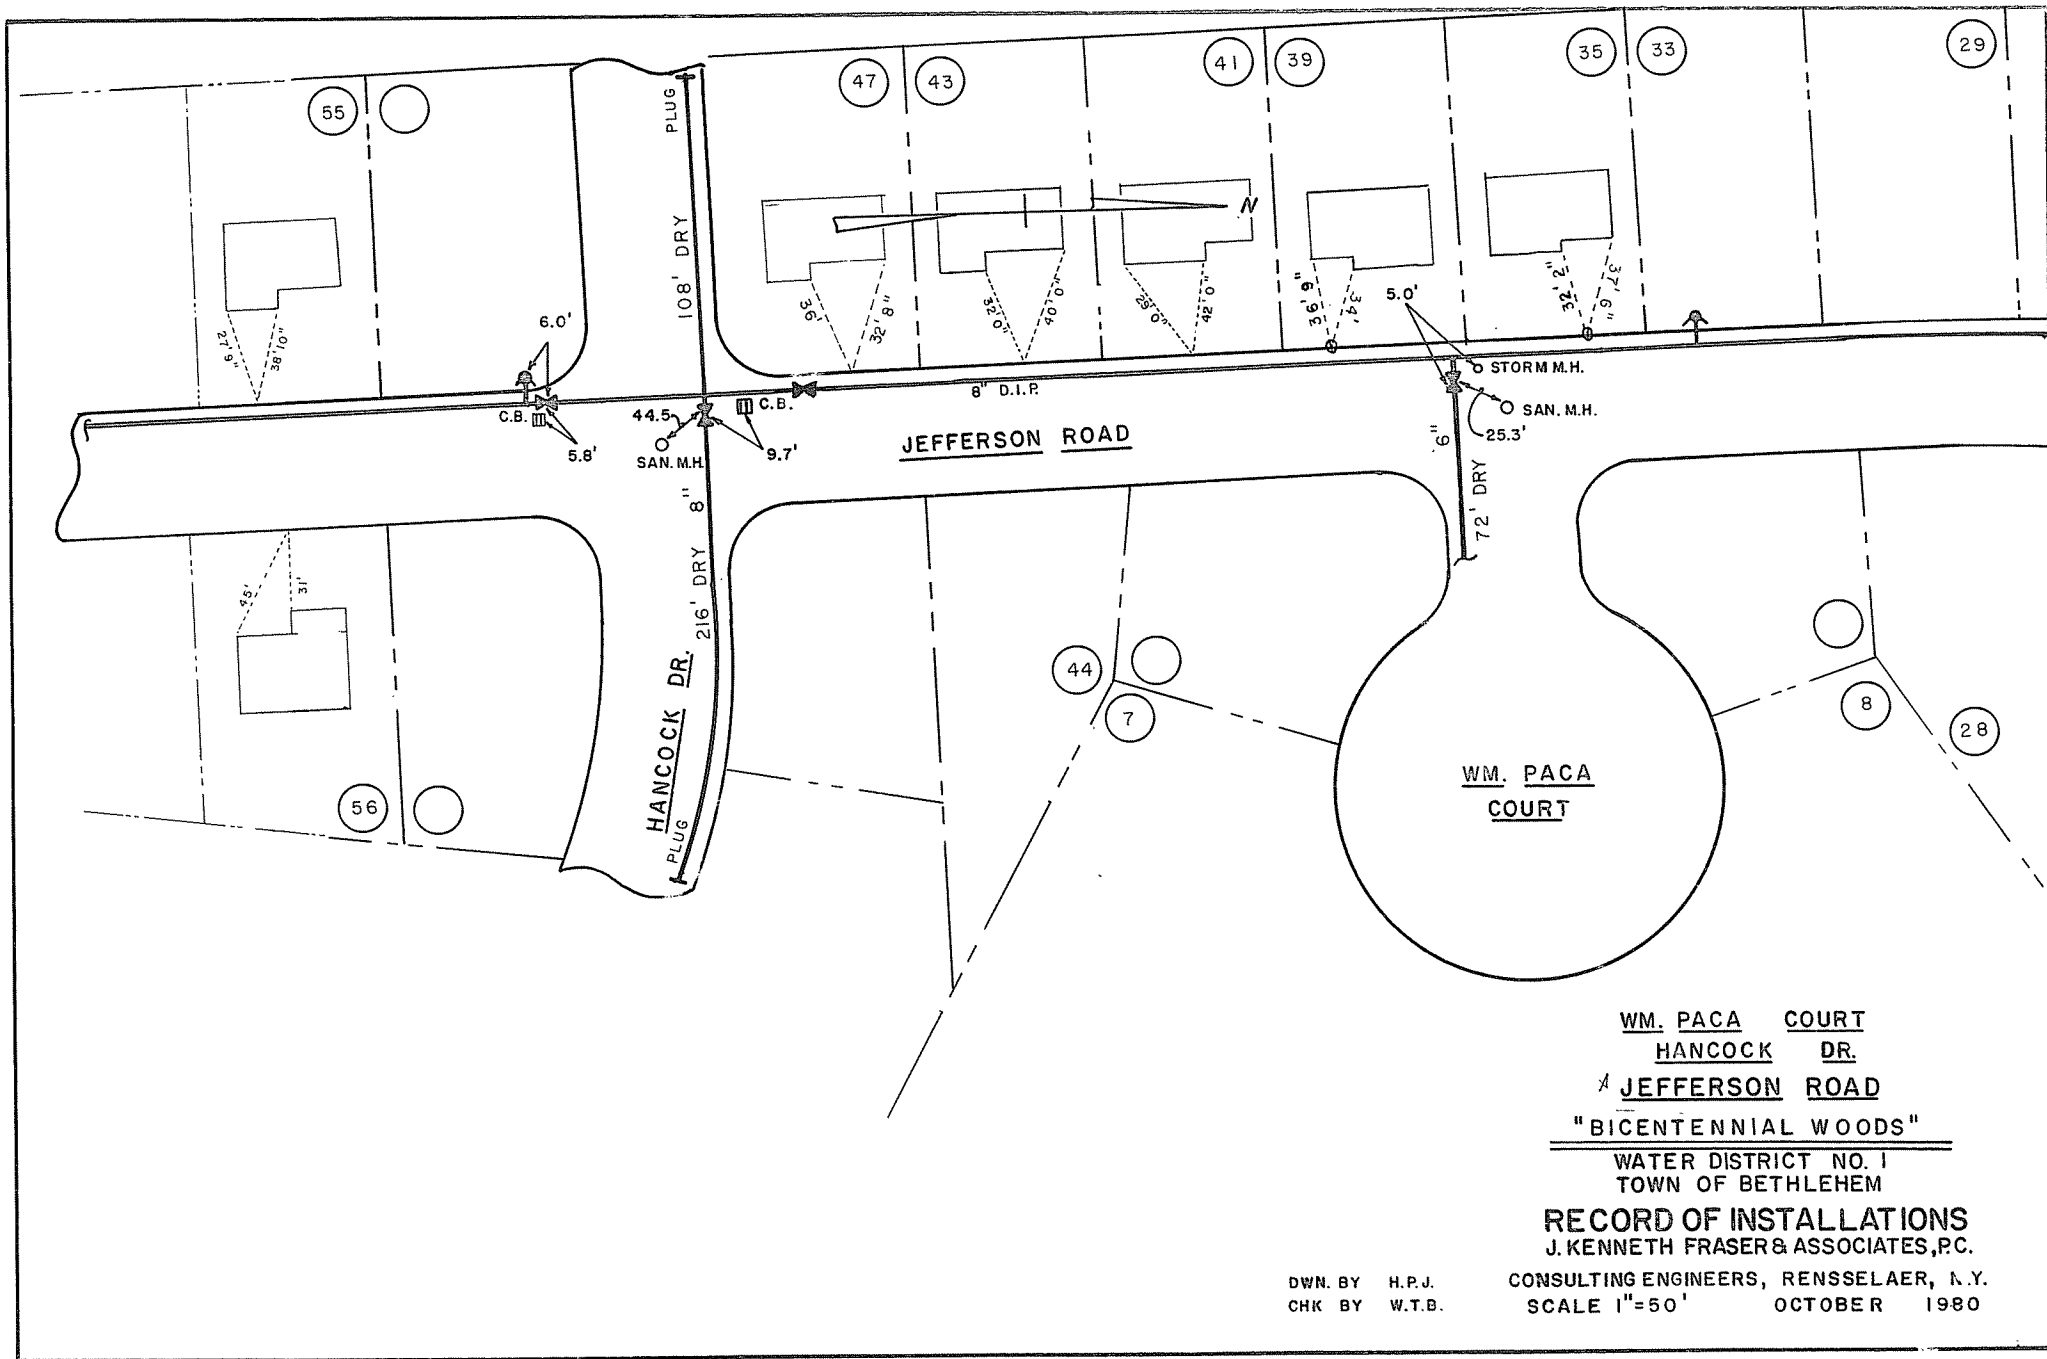

WM. PACA COURT
HANCOCK DR.
JEFFERSON ROAD
"BICENTENNIAL WOODS"
WATER DISTRICT NO. 1
TOWN OF BETHLEHEM
RECORD OF INSTALLATIONS
J. KENNETH FRASER & ASSOCIATES, P.C.
DWN. BY H.P.J.
CHK BY W.T.B.
CONSULTING ENGINEERS, RENSSELAER, N.Y.
SCALE 1"=50' OCTOBER 1980