

JEFFERSON ROAD

WATER DISTRICT NO. 1

TOWN OF BETHLEHEM


RECORD OF INSTALLATION

TOWN OF BETHLEHEM ENGINEERING DEPARTMENT

SCALE : 1" = 50'

JUNE, 1984

DWN, BY: KT

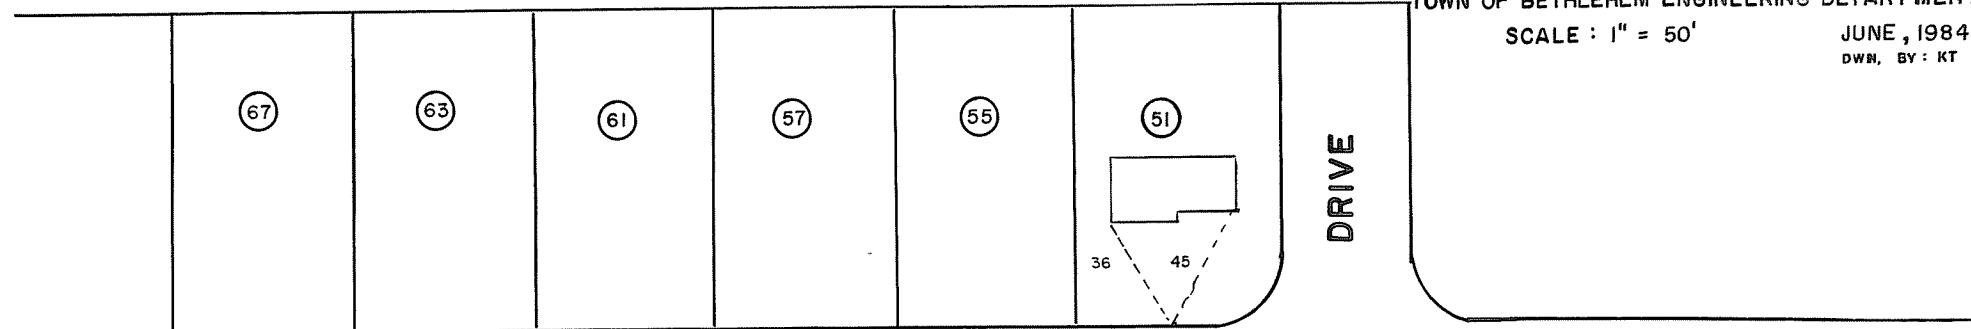

JEFFERSON

ROAD

