


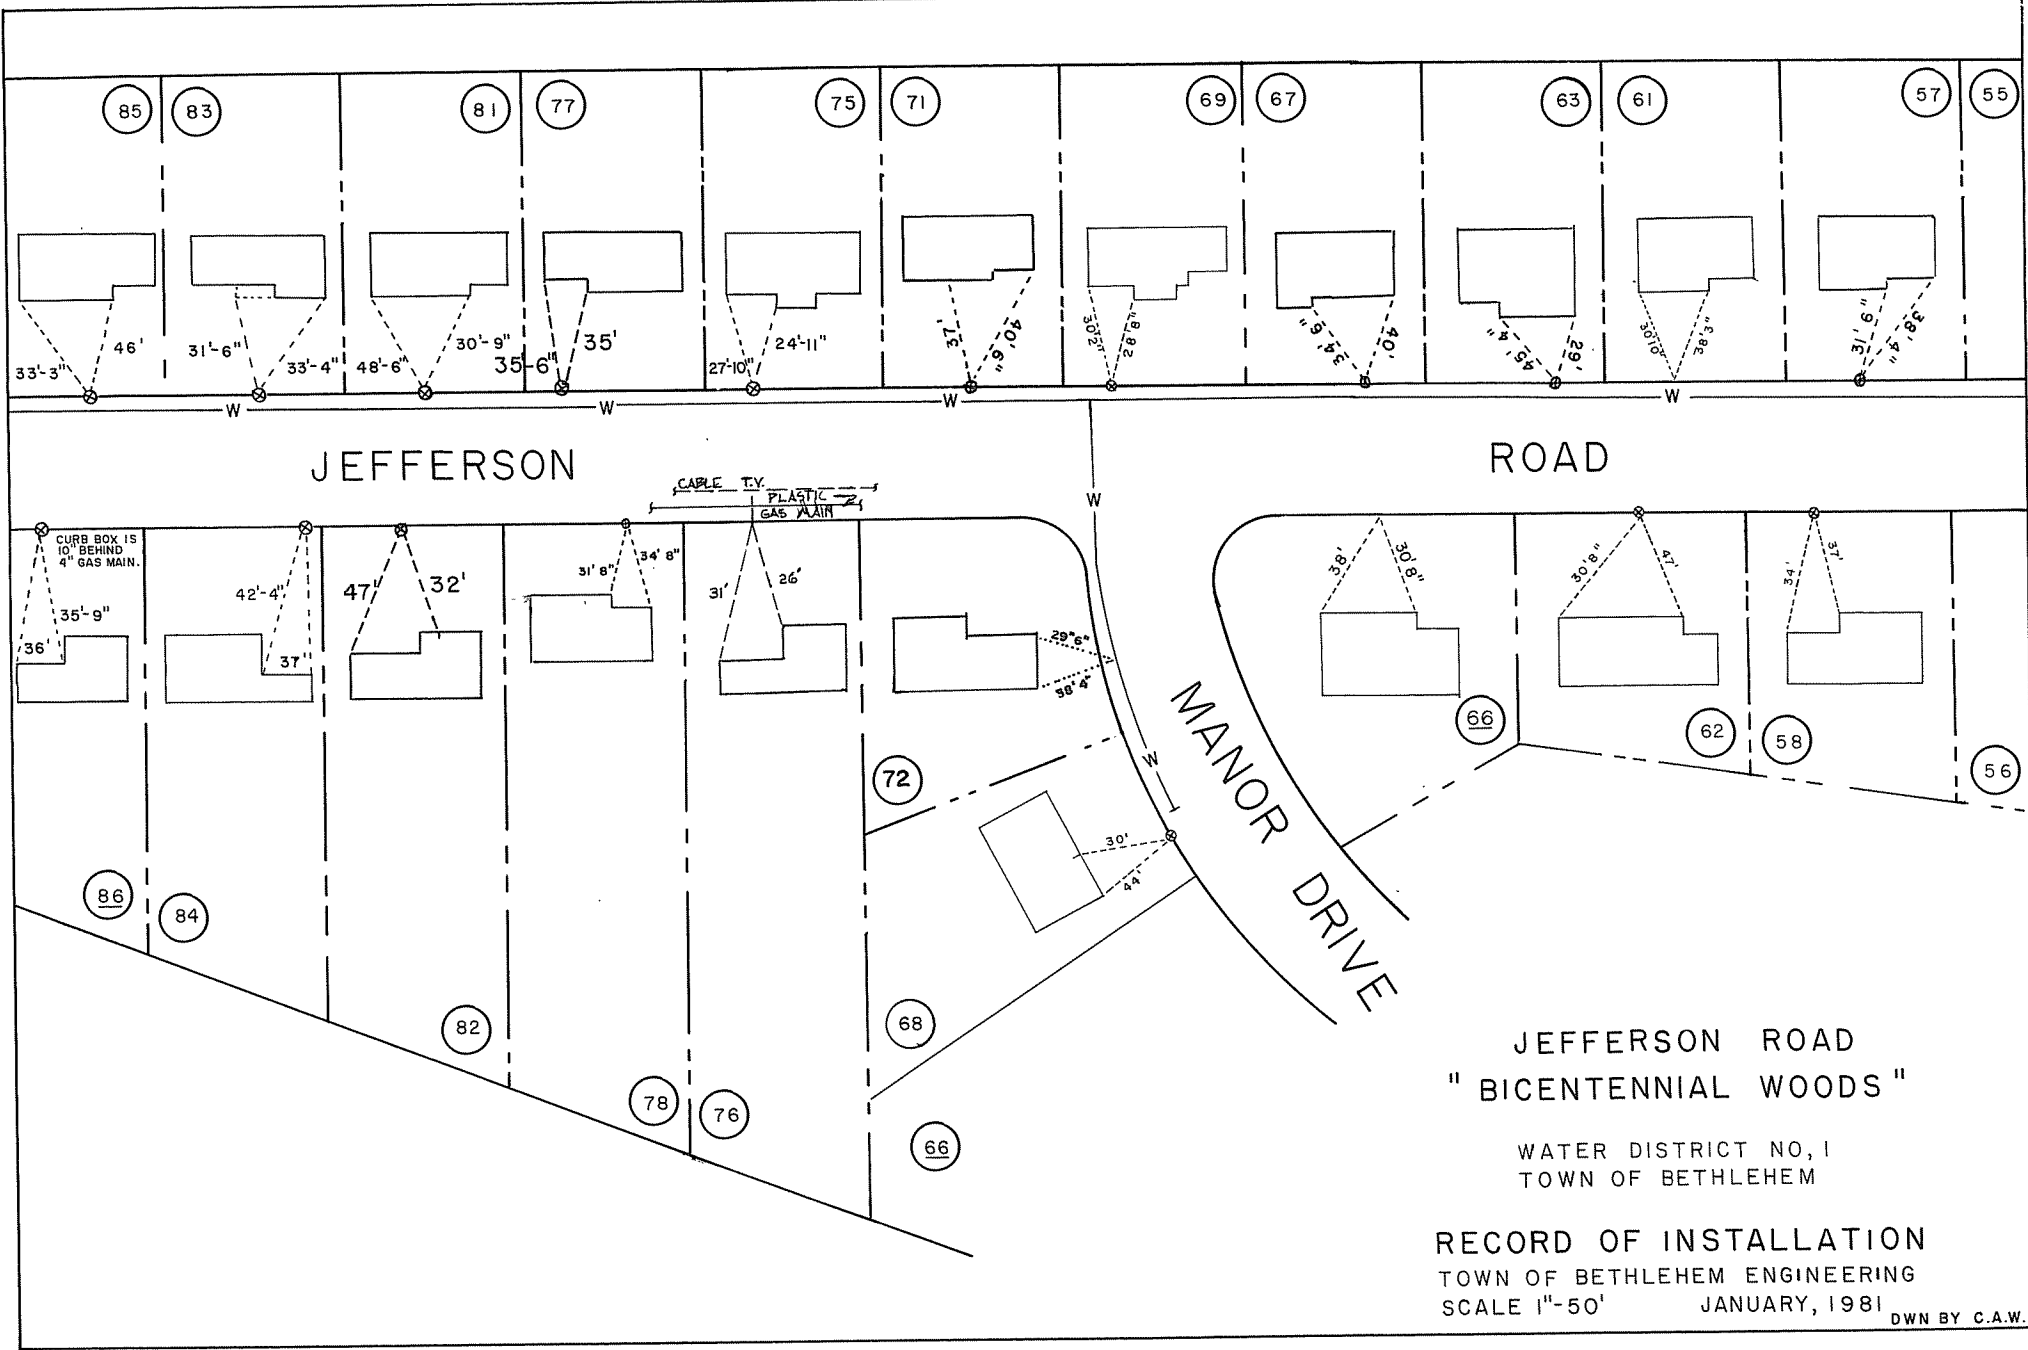

JEFFERSON ROAD
" BICENTENNIAL WOODS "

WATER DISTRICT NO. 1
TOWN OF BETHLEHEM

RECORD OF INSTALLATION
TOWN OF BETHLEHEM ENGINEERING
SCALE 1"=50' JANUARY, 1981

DWN BY C.A.W.