


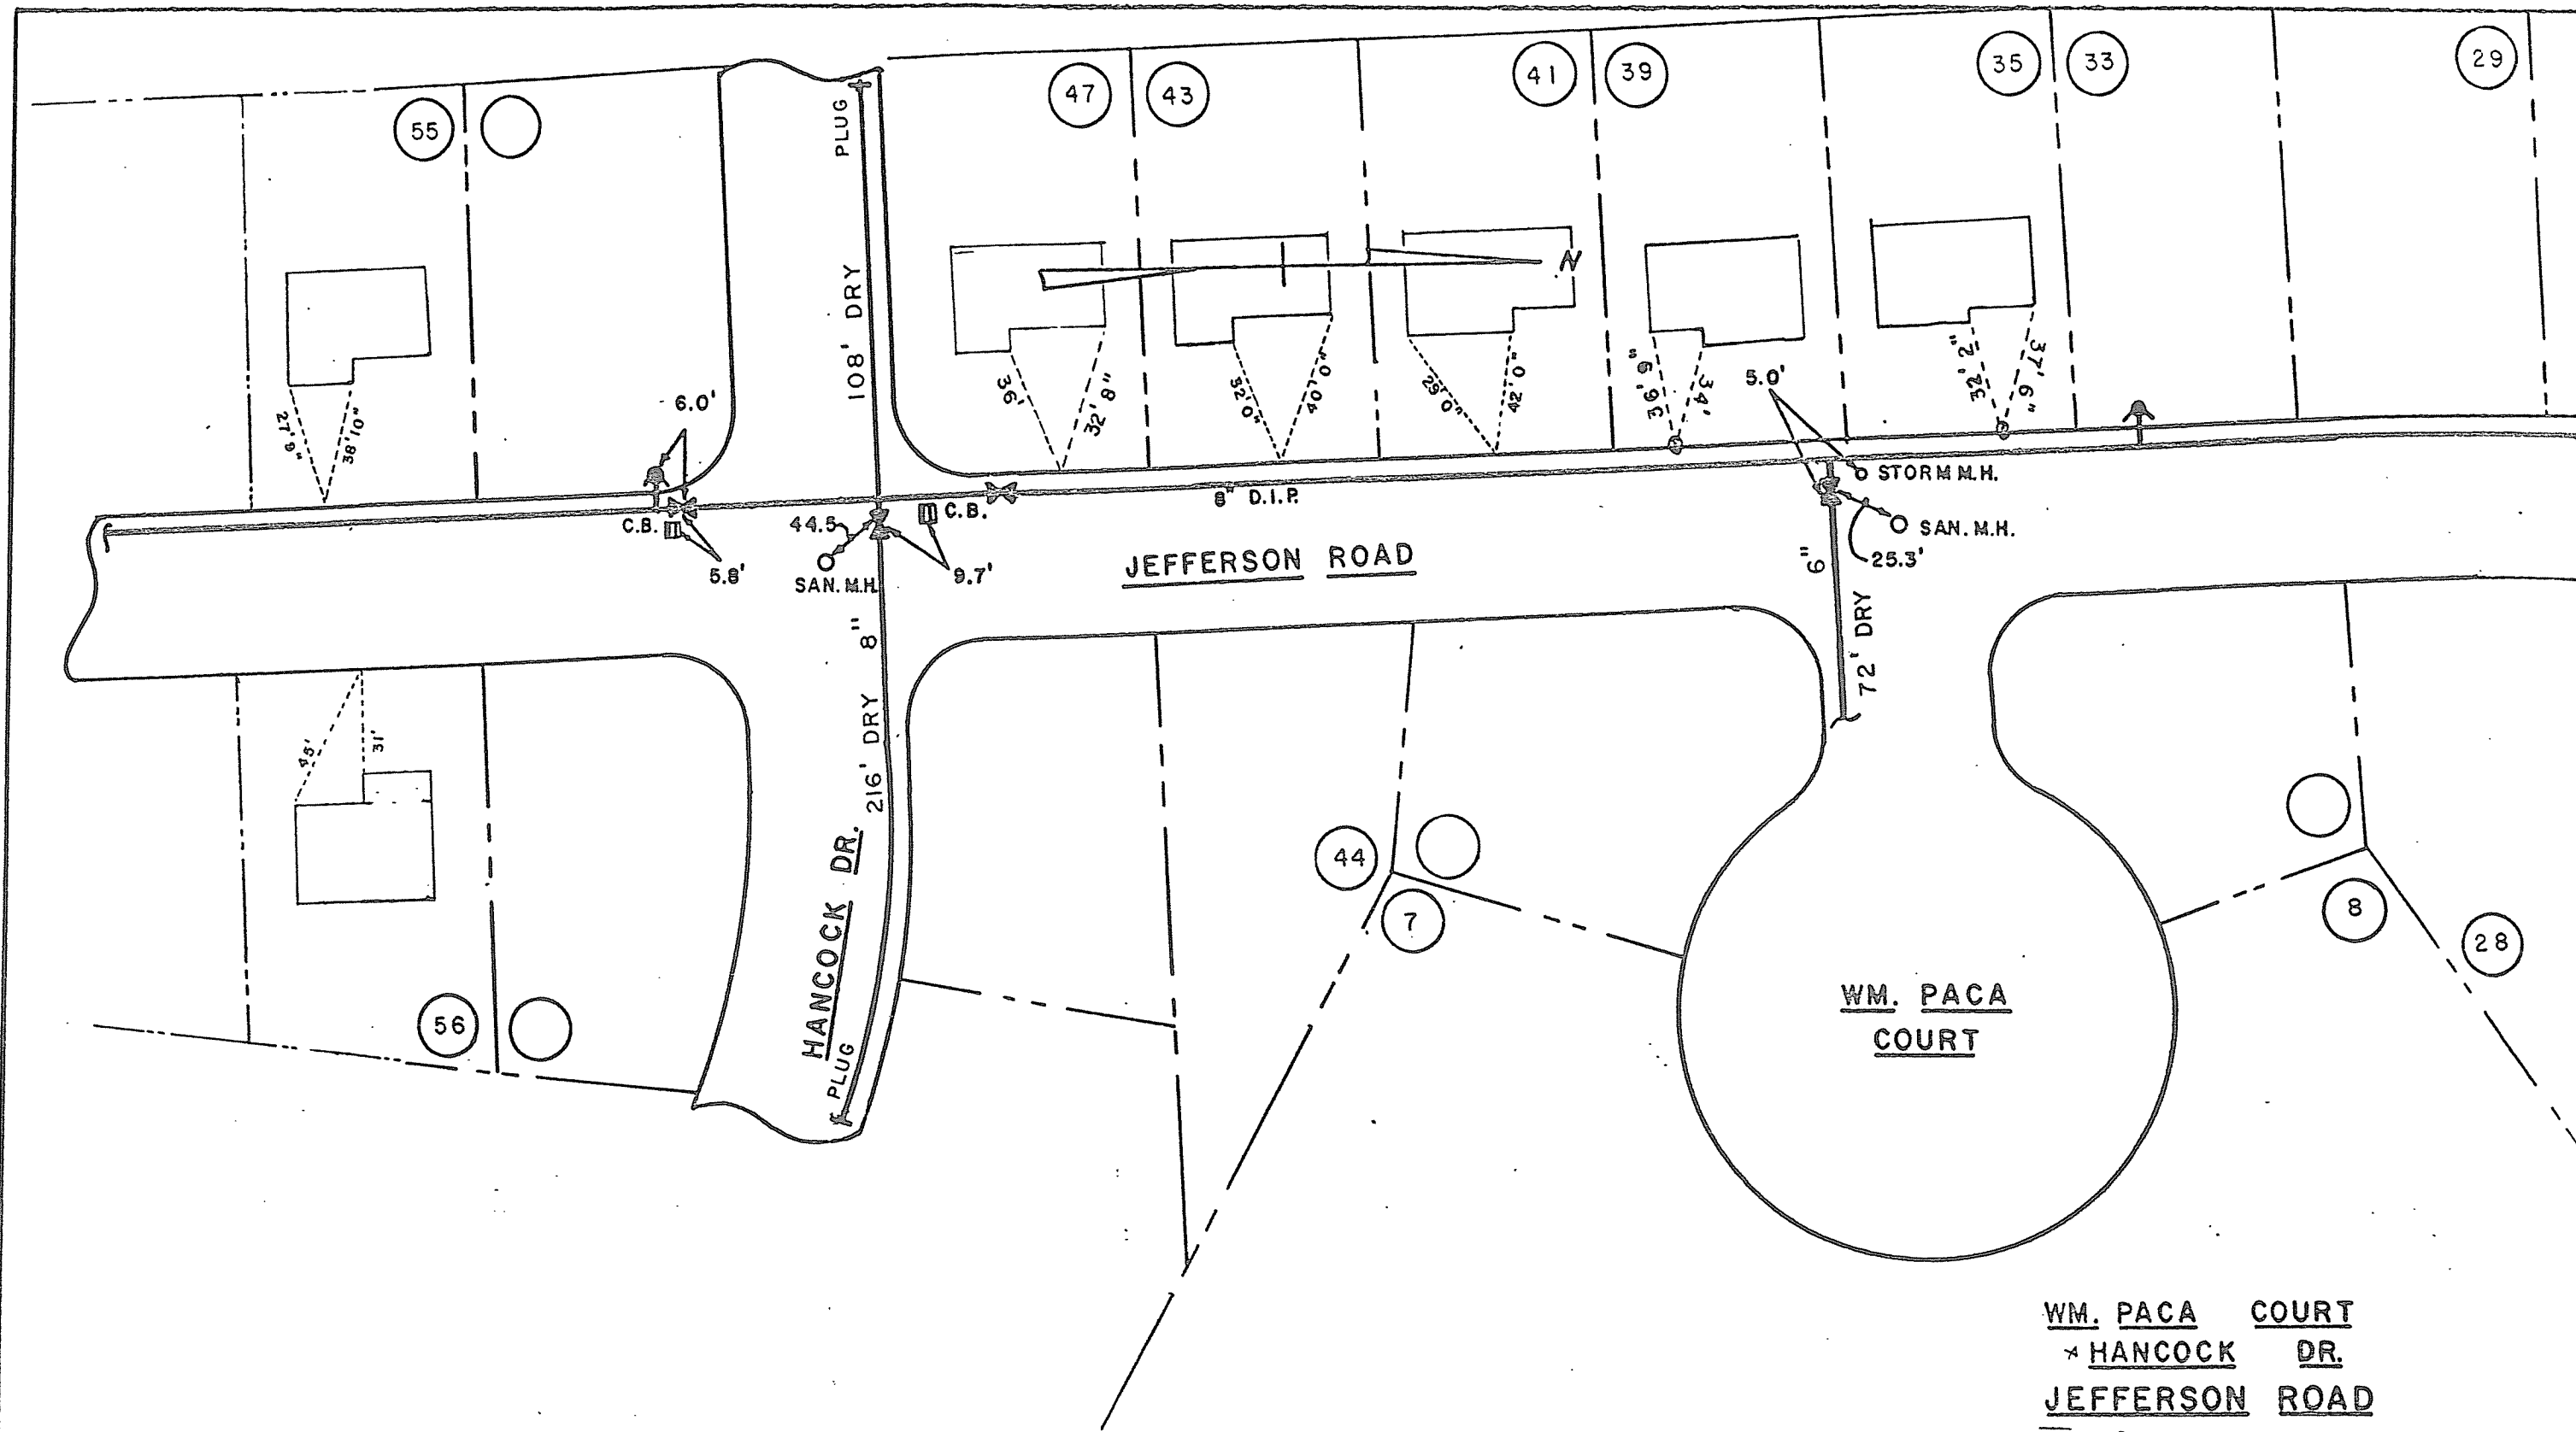

WM. PACA COURT
 & HANCOCK DR.
 JEFFERSON ROAD
 "BICENTENNIAL WOODS"

WATER DISTRICT NO. 1
 TOWN OF BETHLEHEM
 RECORD OF INSTALLATIONS
 J. KENNETH FRASER & ASSOCIATES, P.C.
 CONSULTING ENGINEERS, RENSSELAER, N.Y.
 SCALE 1"=50' OCTOBER 1980

DWR. BY H.P.J.
 CHK BY W.T.B.

HANCOCK DR.