
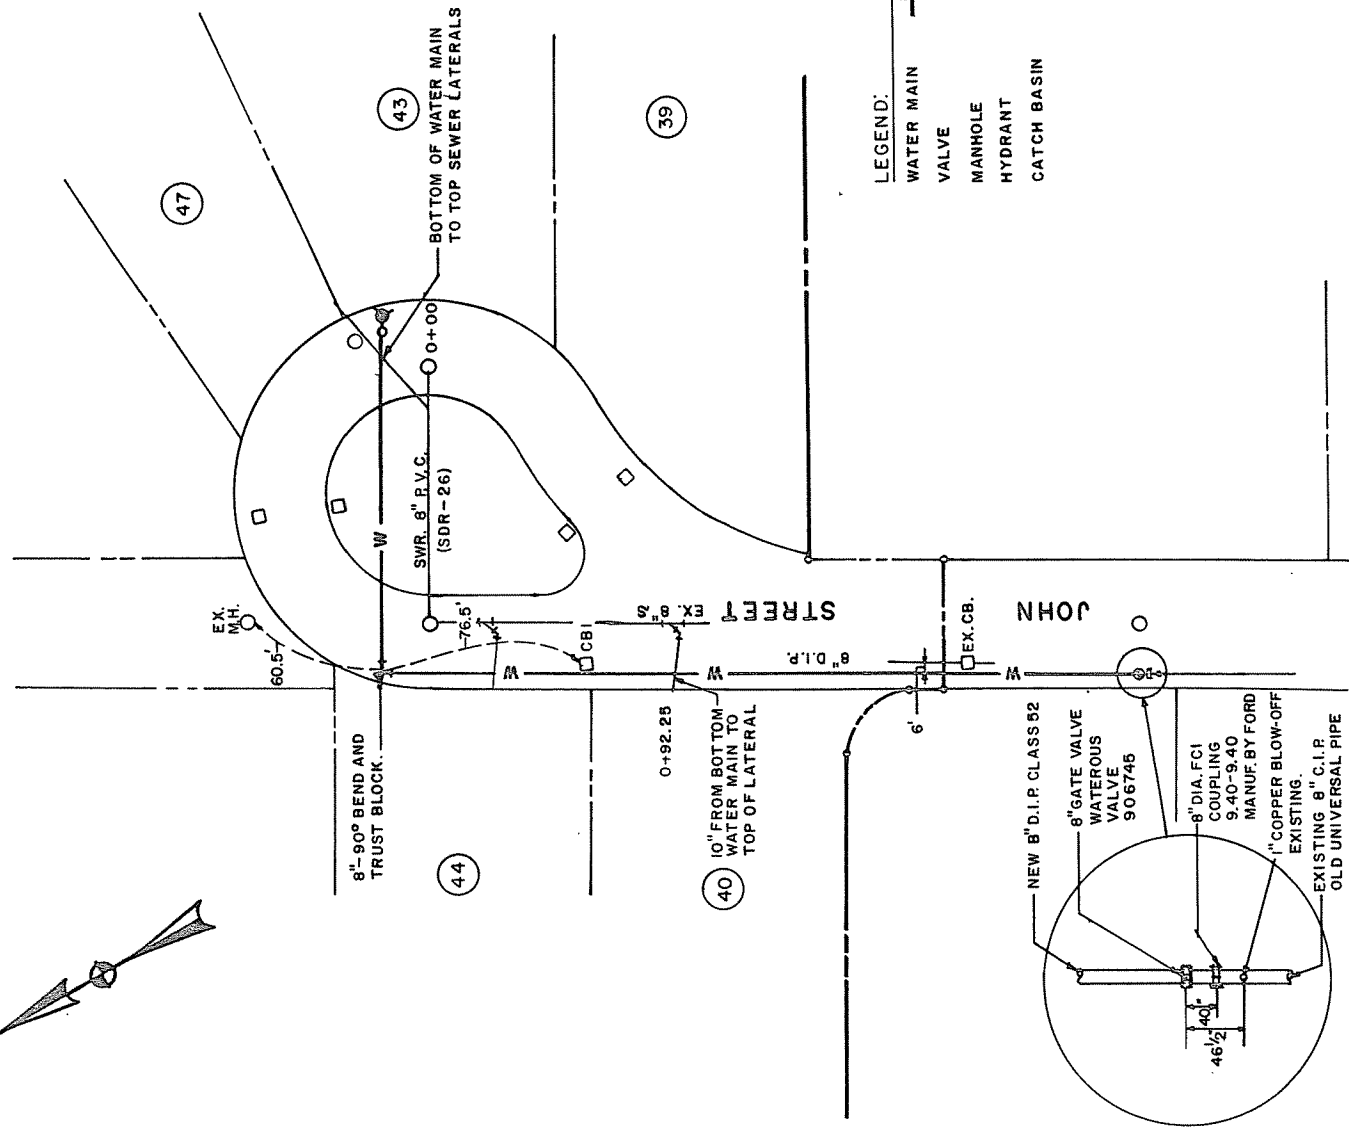


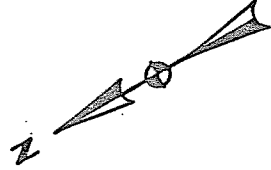

LEGEND:

- | | |
|-------------|-------------|
| WATER MAIN | 8" W.D.I.P. |
| VALVE | ⊕ |
| MANHOLE | ○ |
| HYDRANT | ⊙ |
| CATCH BASIN | □ |

JOHN STREET WATER MAIN

APRIL 1992 RECORD
 SCALE: 1"=50' DRAWING
 BY J.A.T. CONSTRUCTION
 DRAWN BY M.G.
 CHECKED BY D.M.S.