


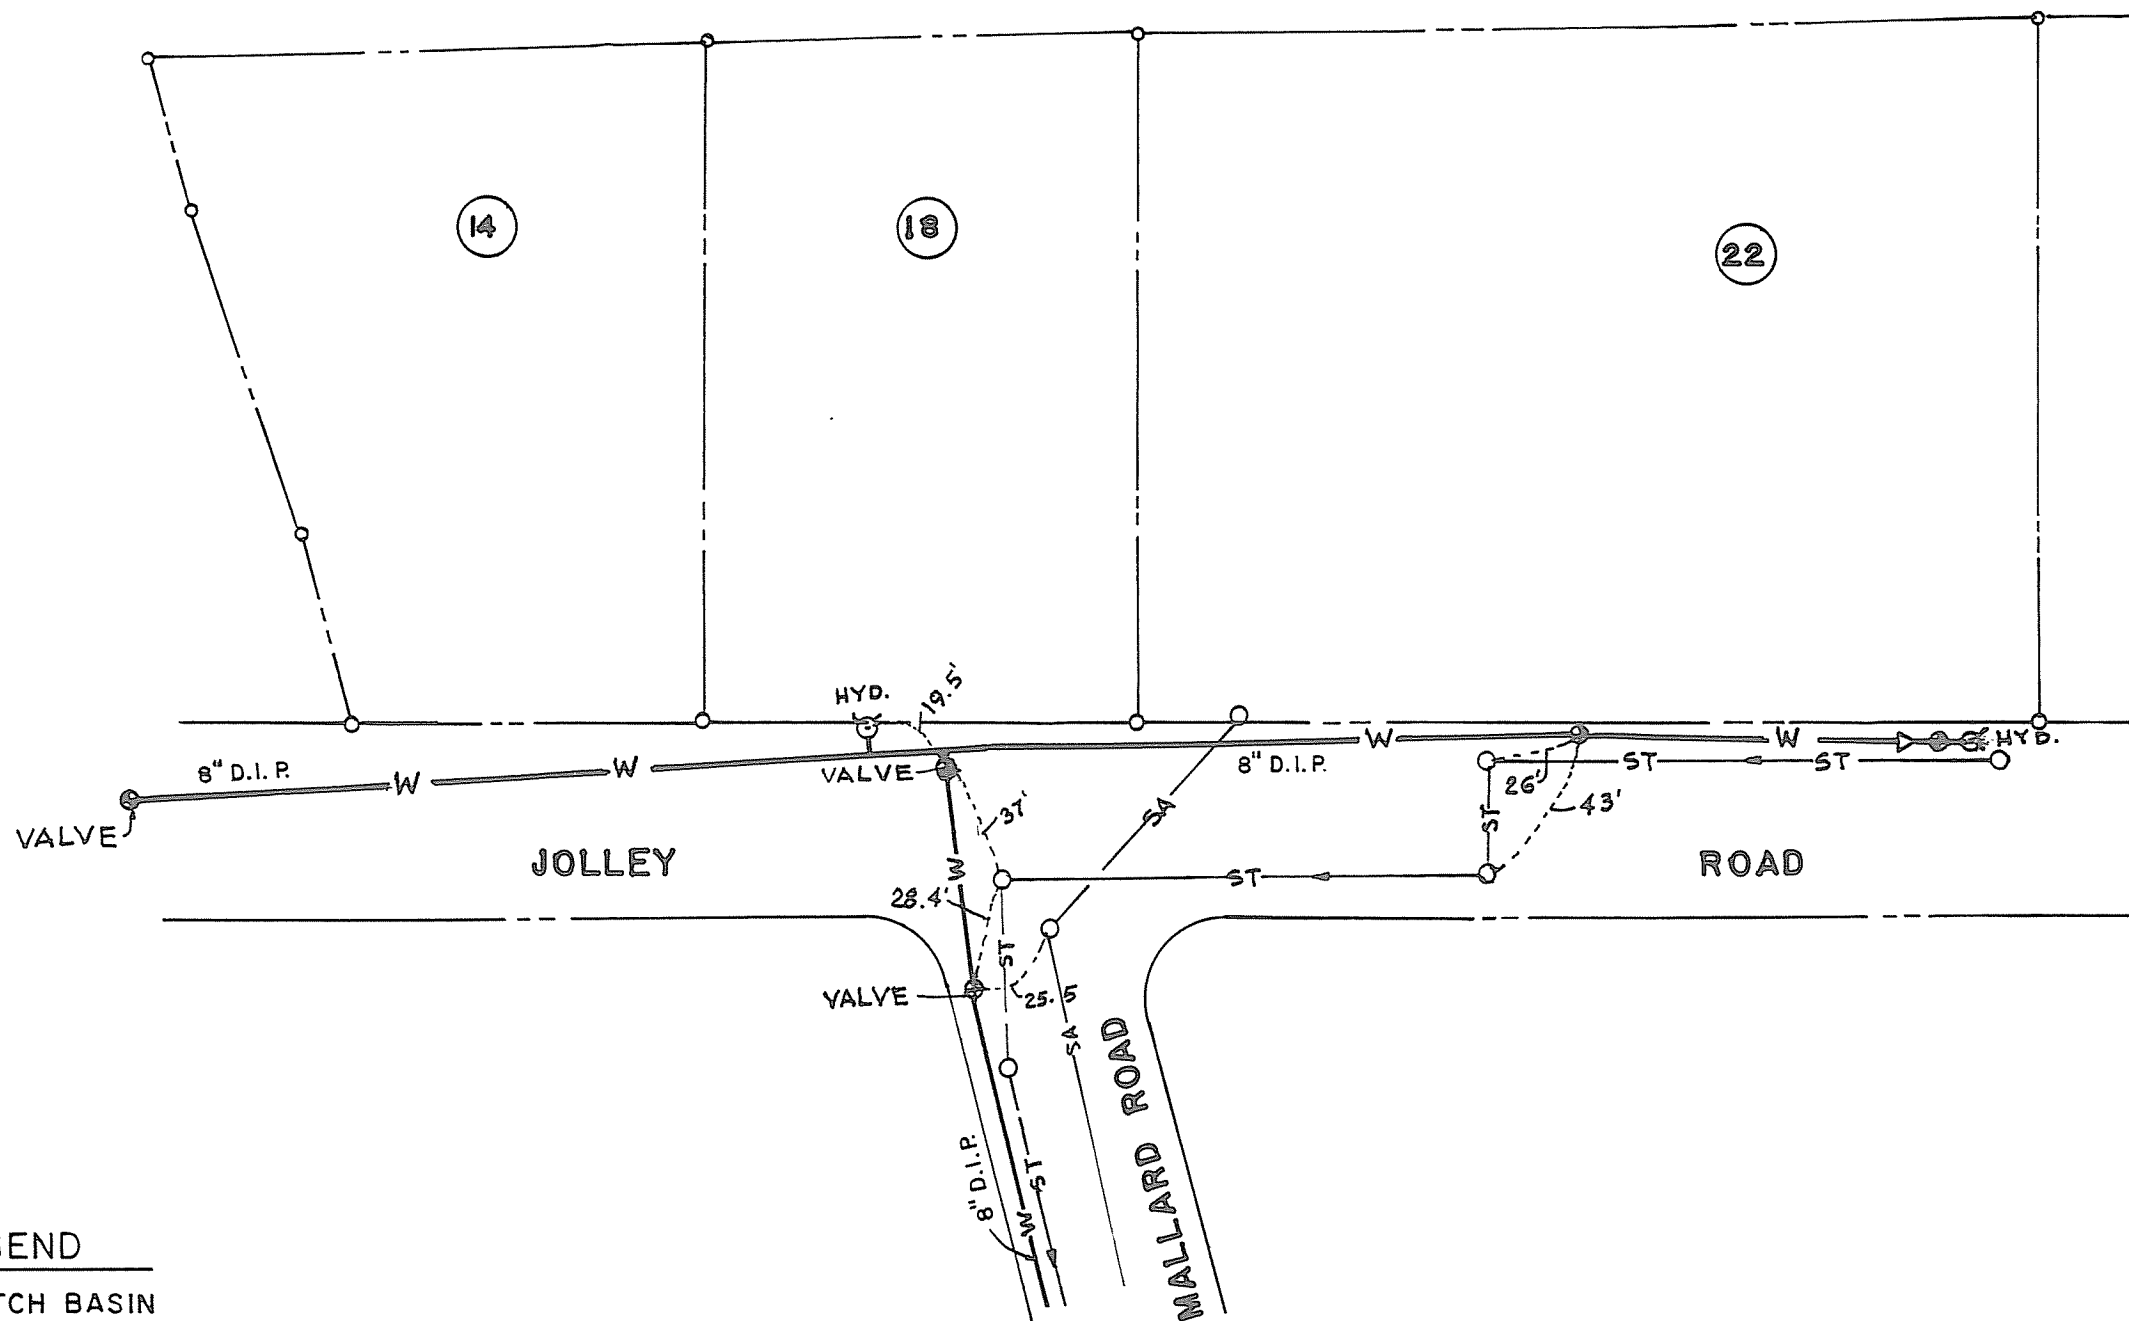

LEGEND

- CATCH BASIN
- MANHOLE
- ⊙ HYDRANT
- ⊕ GATE VALVE
- ⊥ TEE
- ▲ THRUST BLOCK
- W — WATER MAIN
- SA — SANITARY SEWER
- ST --- STORM SEWER

COUNTY ALBANY	JOLLEY ROAD WATER MAIN	STATE NEW YORK
DATE NOV. 19, 1996		SCALE 1" = 50'
REVISION	 TOWN OF BETHLEHEM ENGINEERING DIVISION 445 Delaware Ave. Delmar, New York 12054	DRAWING NO.