


WORK ACCOMPLISHED BY
TOWN FORCES-JUNE 1978

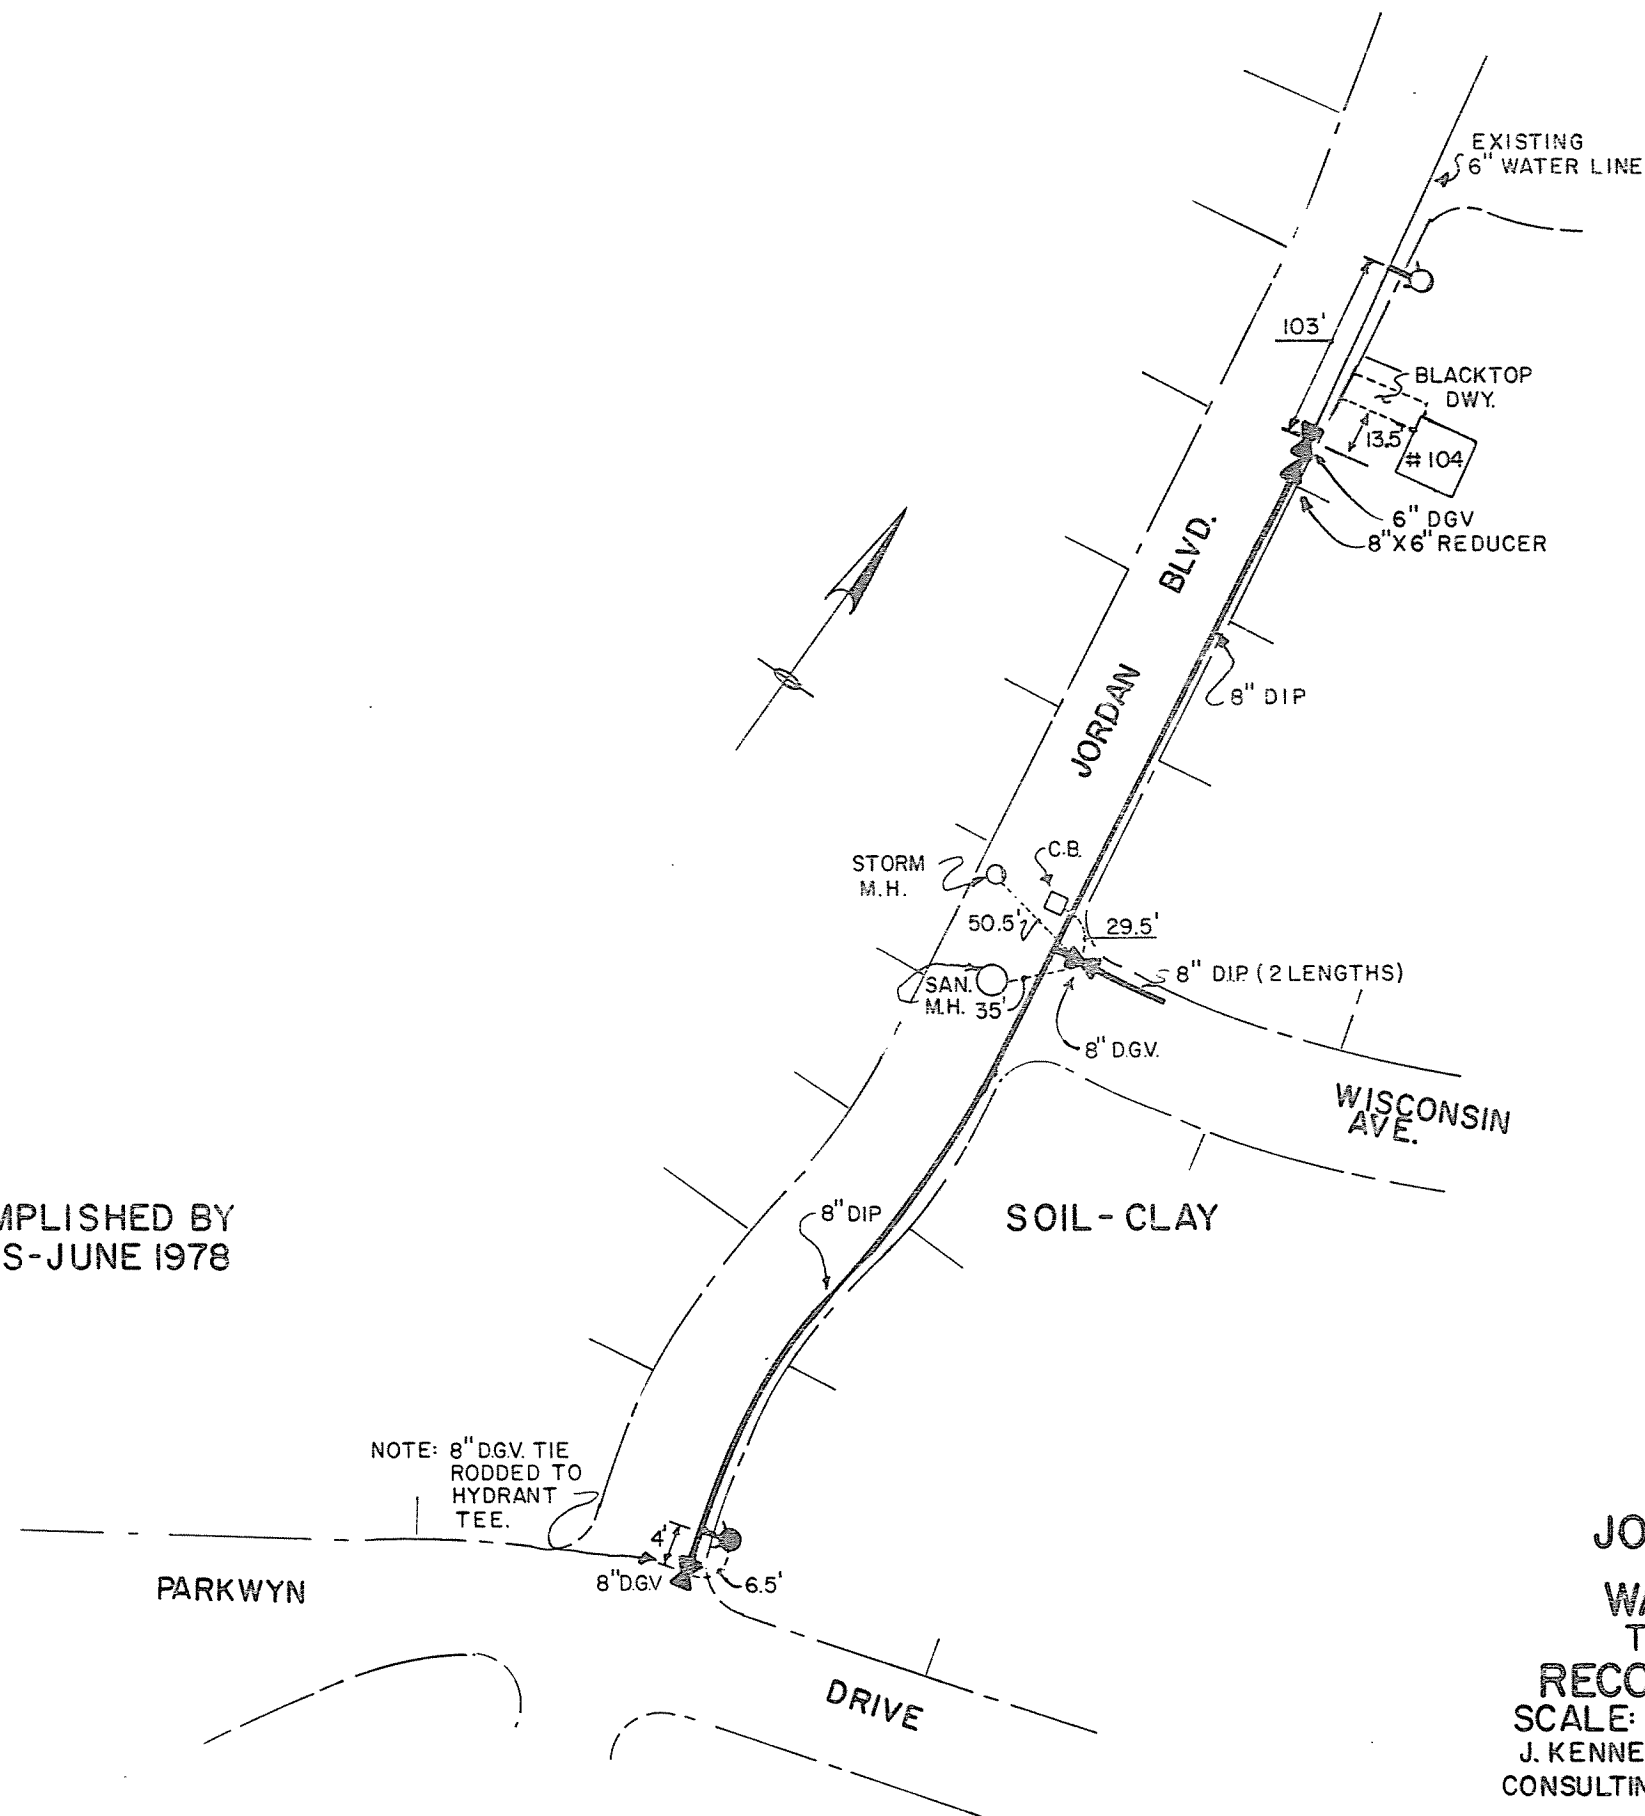

DWN. BY - GLM.
CKD. BY - W.T.B.

JORDAN BOULEVARD
WATER DISTRICT No. 1
TOWN OF BETHLEHEM
RECORD OF INSTALLATION
SCALE: 1" = 100' JULY 1978
J. KENNETH FRASER & ASSOCIATES, P. C.
CONSULTING ENGINEERS RENSSELAER, N. Y.