


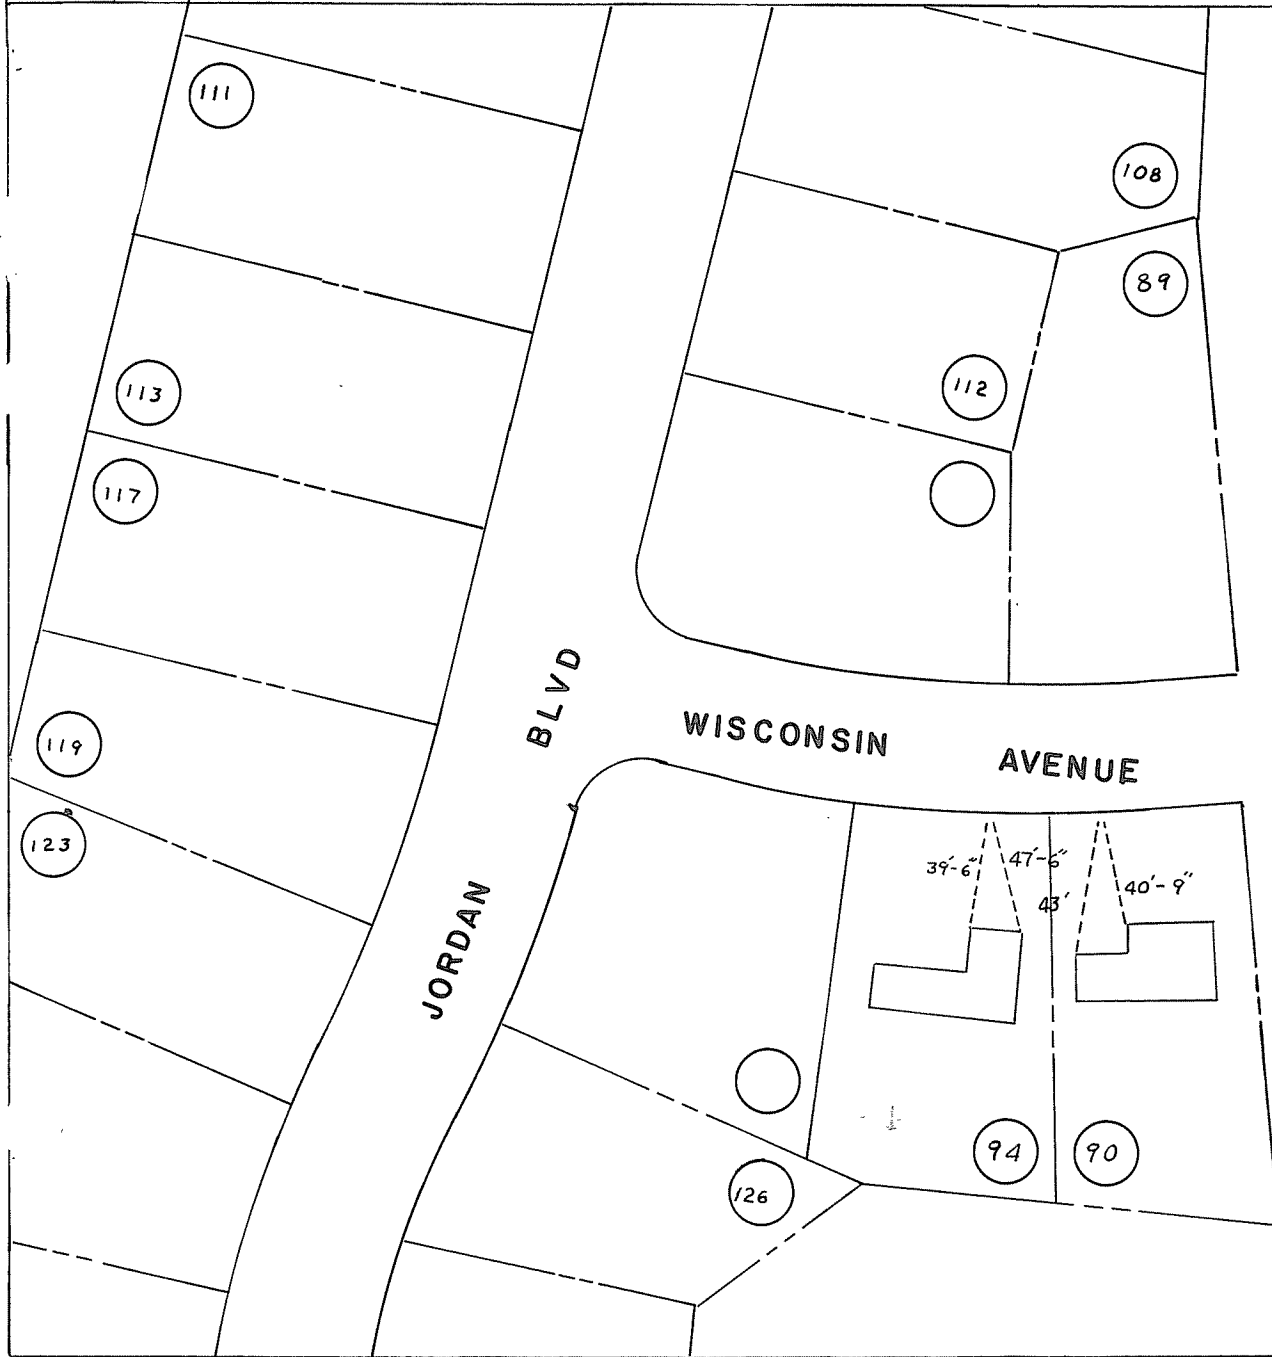

JORDAN BLVD

WISCONSIN AVENUE

SCALE: 1" = 50'	
DRAWN BY: REB	
APPROVED:	
DATE:	
	TOWN OF BETHLEHEM
	ENGINEERING DEPARTMENT
445 DELAWARE AVE. DELMAR, NEW YORK 12054	
DRAWING NUMBER:	