


PARKWYN DRIVE

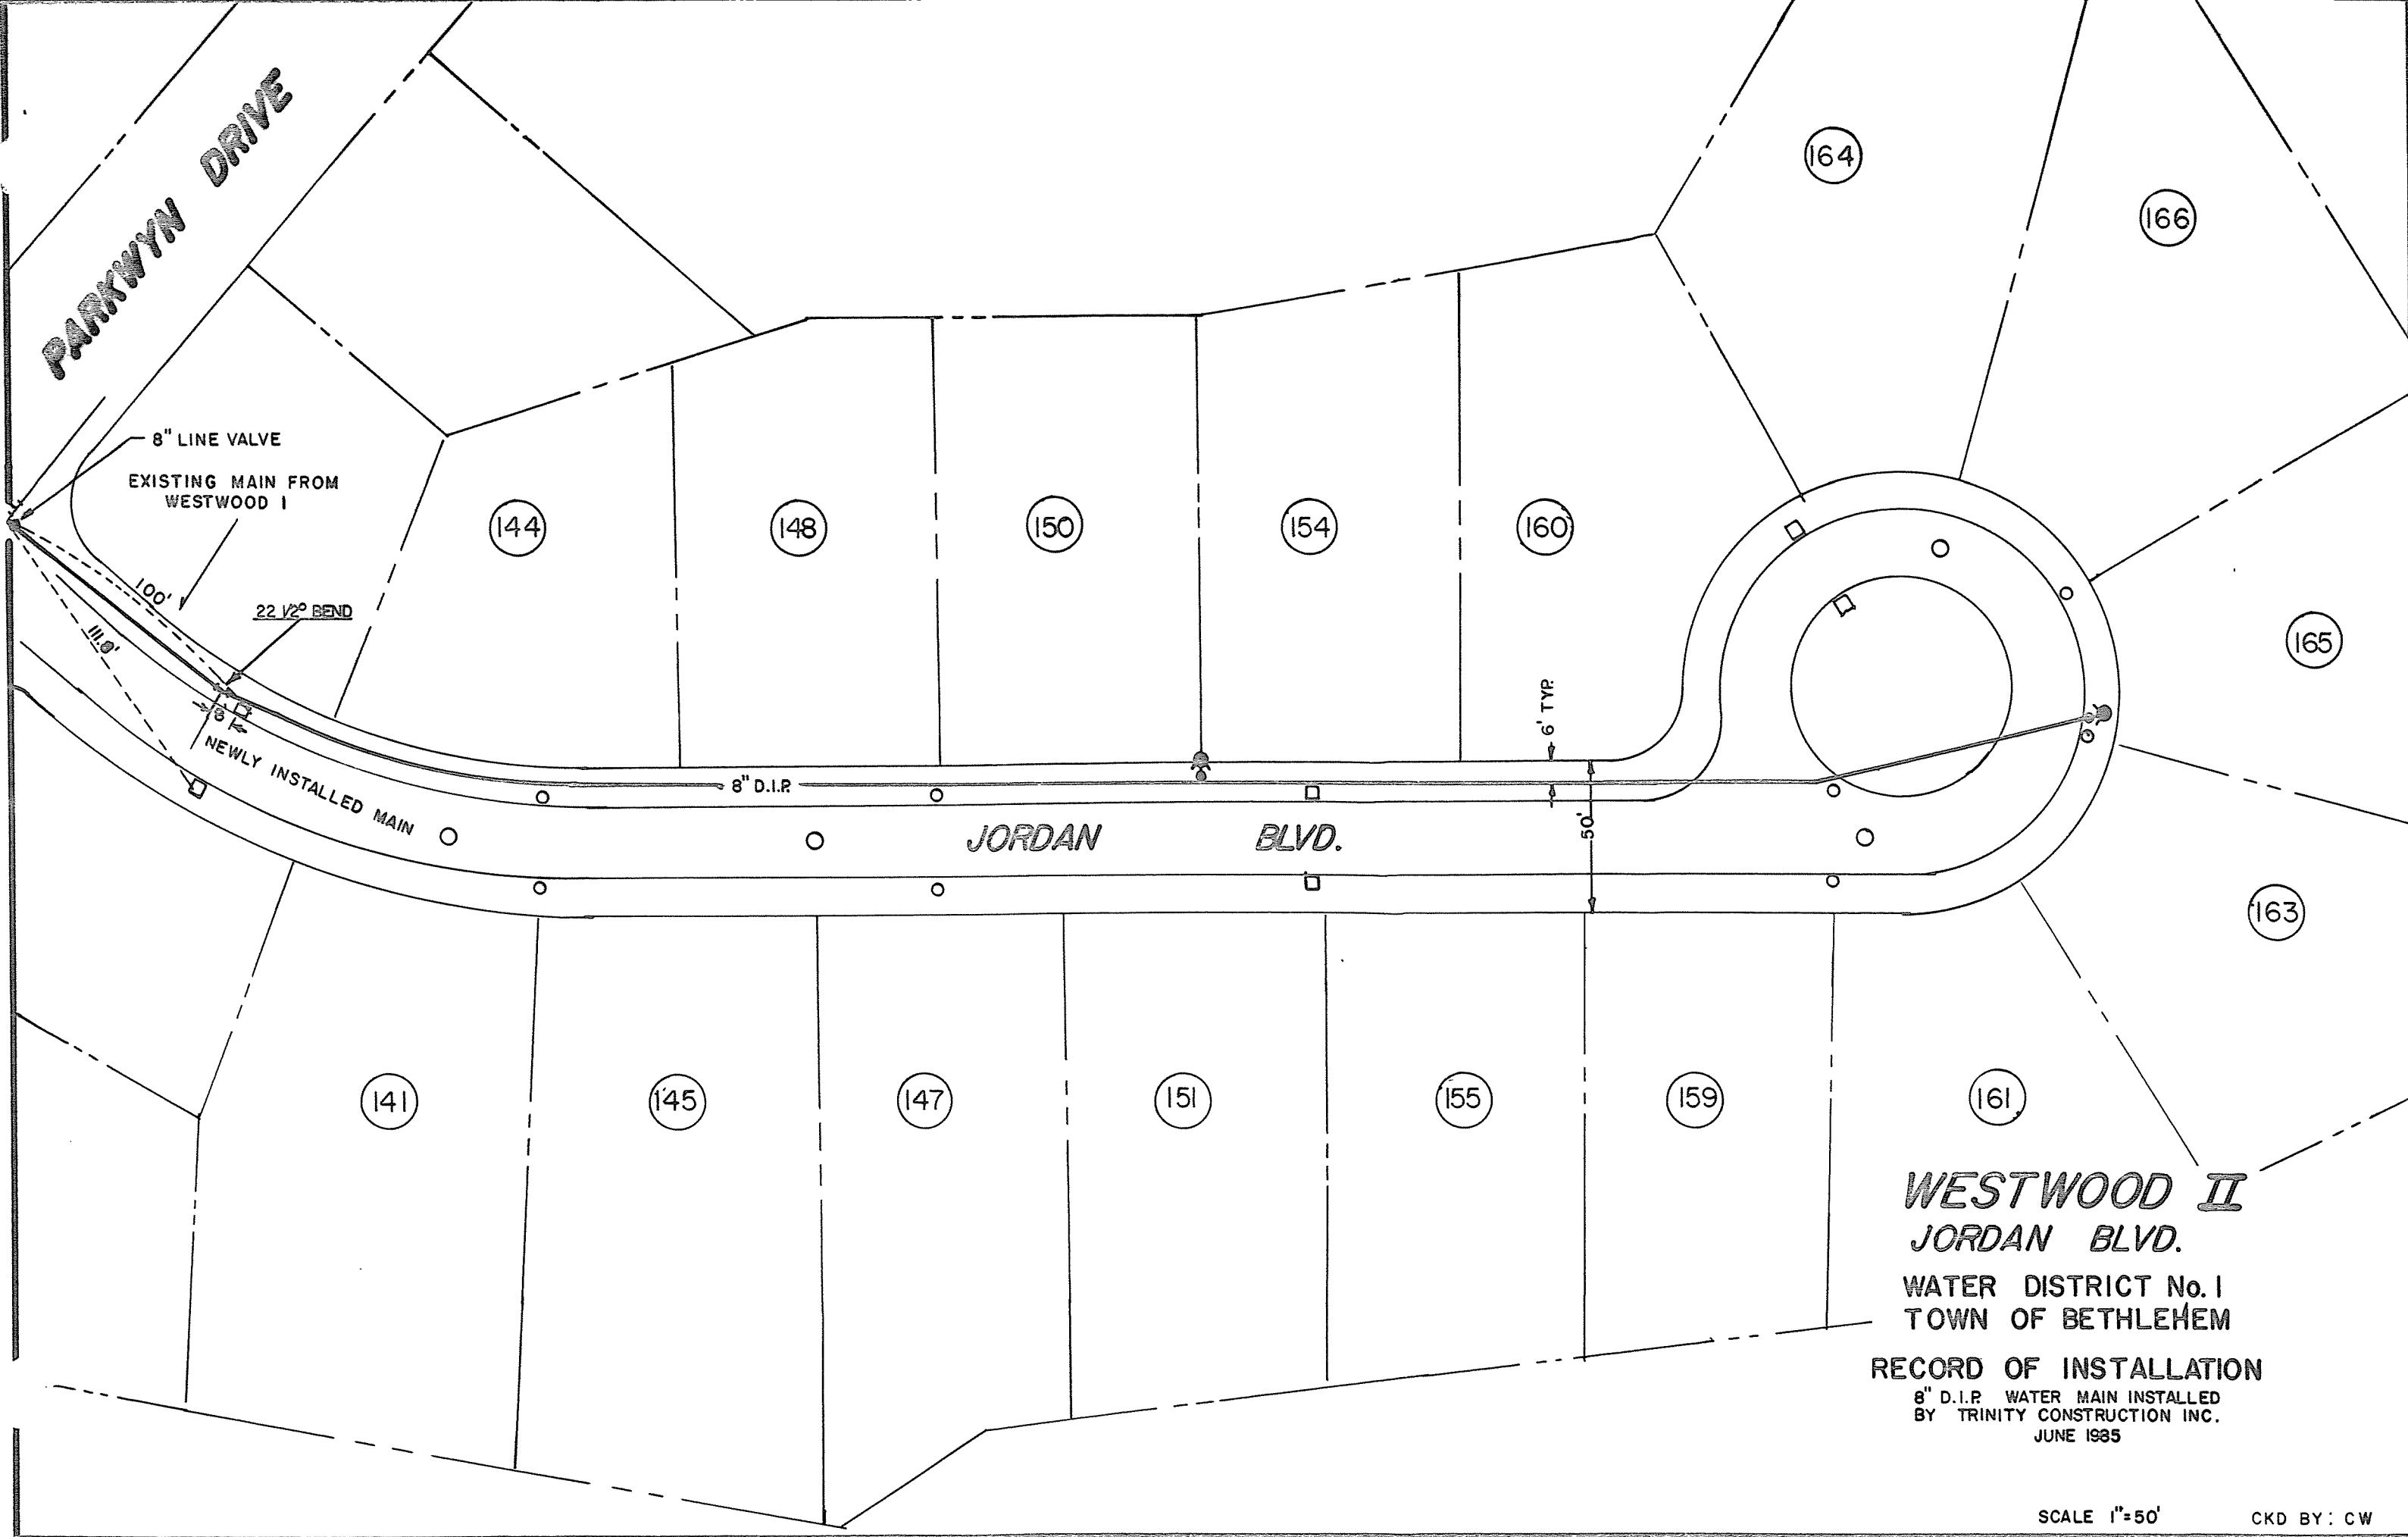

WESTWOOD II
JORDAN BLVD.

WATER DISTRICT No. 1
TOWN OF BETHLEHEM

RECORD OF INSTALLATION

8" D.I.P. WATER MAIN INSTALLED
BY TRINITY CONSTRUCTION INC.
JUNE 1985