


Parkwyn Drive

Jordan Blvd.

26

144

148

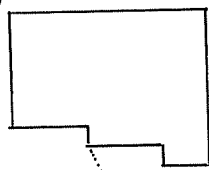

42

141

145

147



JORDAN BLVD
Parkwyn Drive

SCALE:
1" = 50'
DRAWN BY:
R E B
APPROVED:
DATE:



TOWN OF BETHLEHEM
ENGINEERING DEPARTMENT
400 DELAWARE AVE. BETHLEHEM, PA 18010