




SCALE.
1" = 50'
DRAWN BY.
R E B
APPROVED,
DATE.

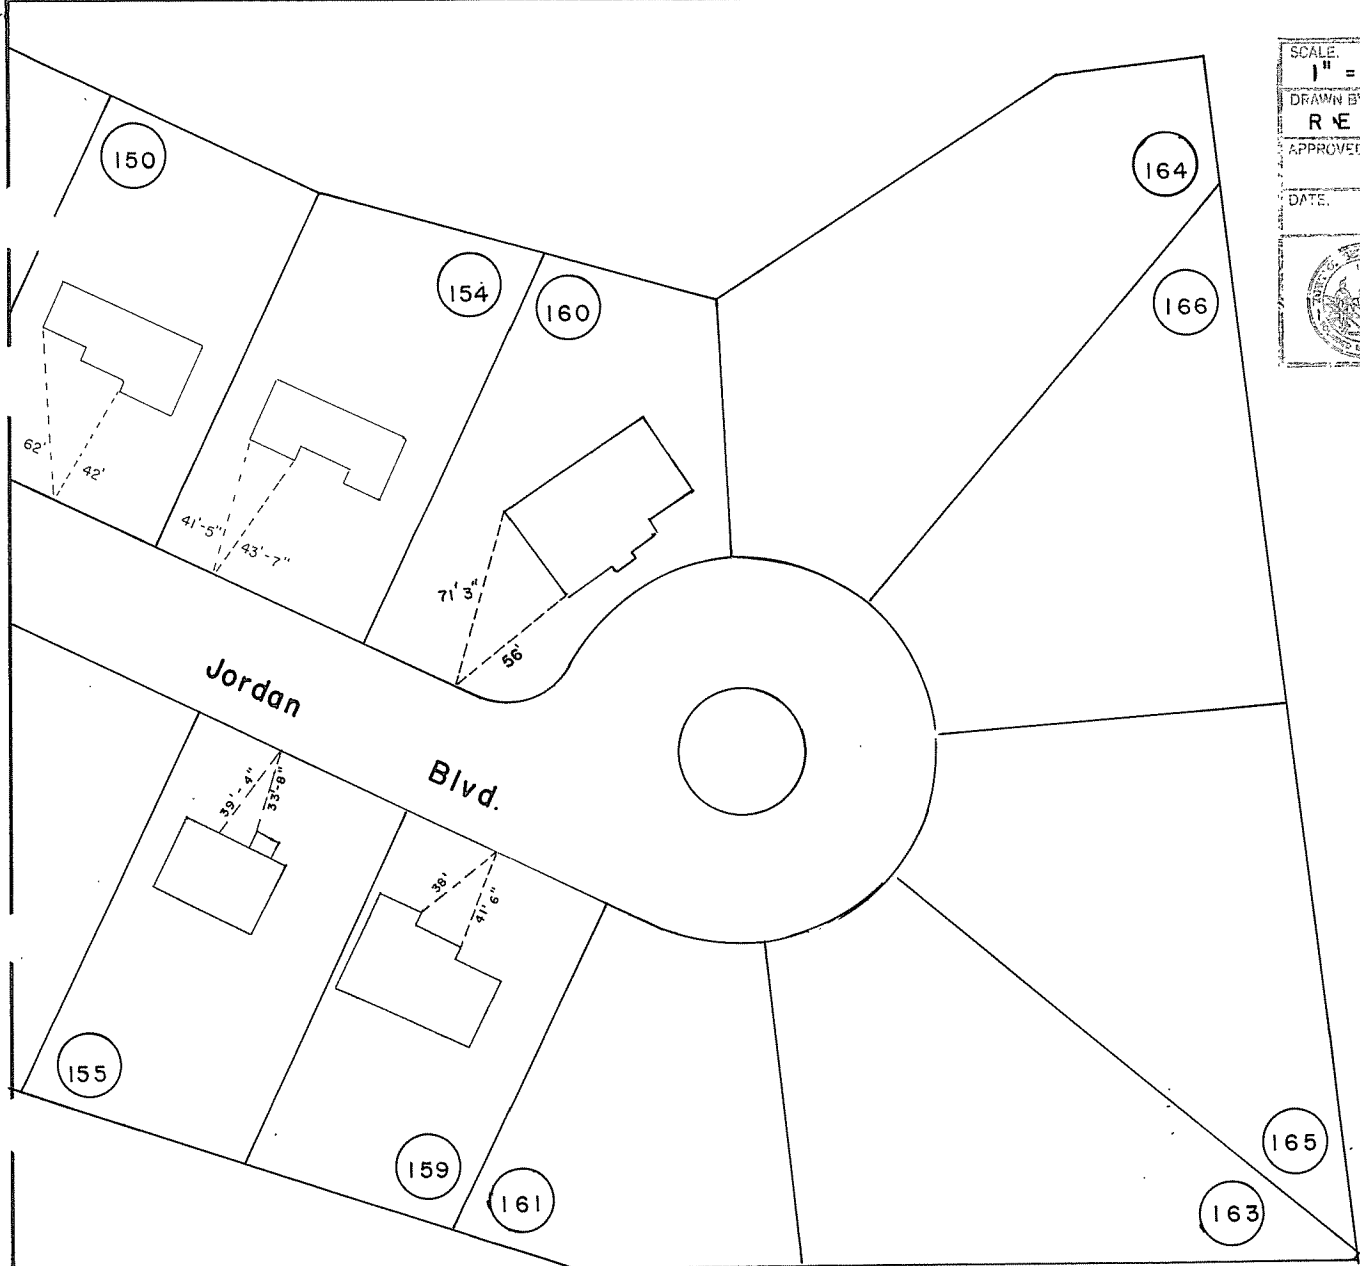

TOWN OF BETHLEHEM
ENGINEERING DEPARTMENT
449 DELAWARE AVE. DELMAR, NEW YORK 10016

JORDAN BLVD.