
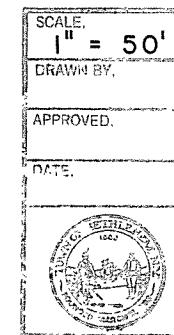


JORDAN BLVD.

Jordan Blvd.

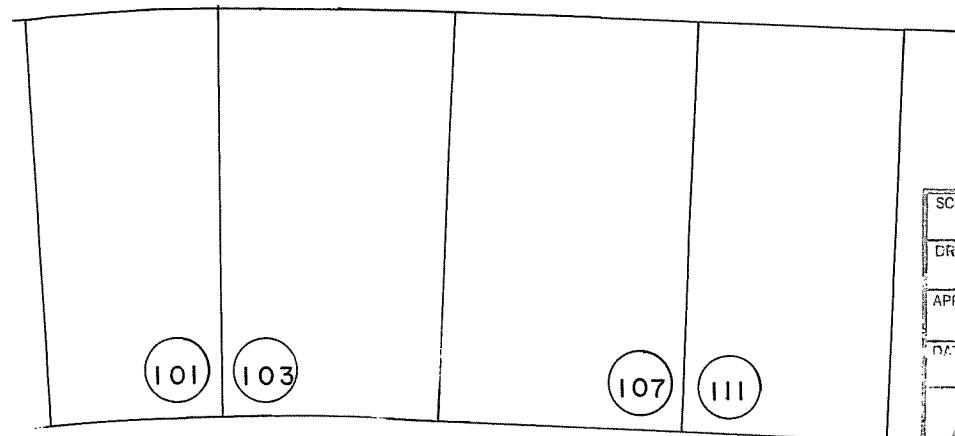

TOWN OF BETHLEHEM
ENGINEERING DEPARTMENT

448 DELAWARE AVE. DELMAR, NEW YORK 12054

DRAWING NUMBER: