


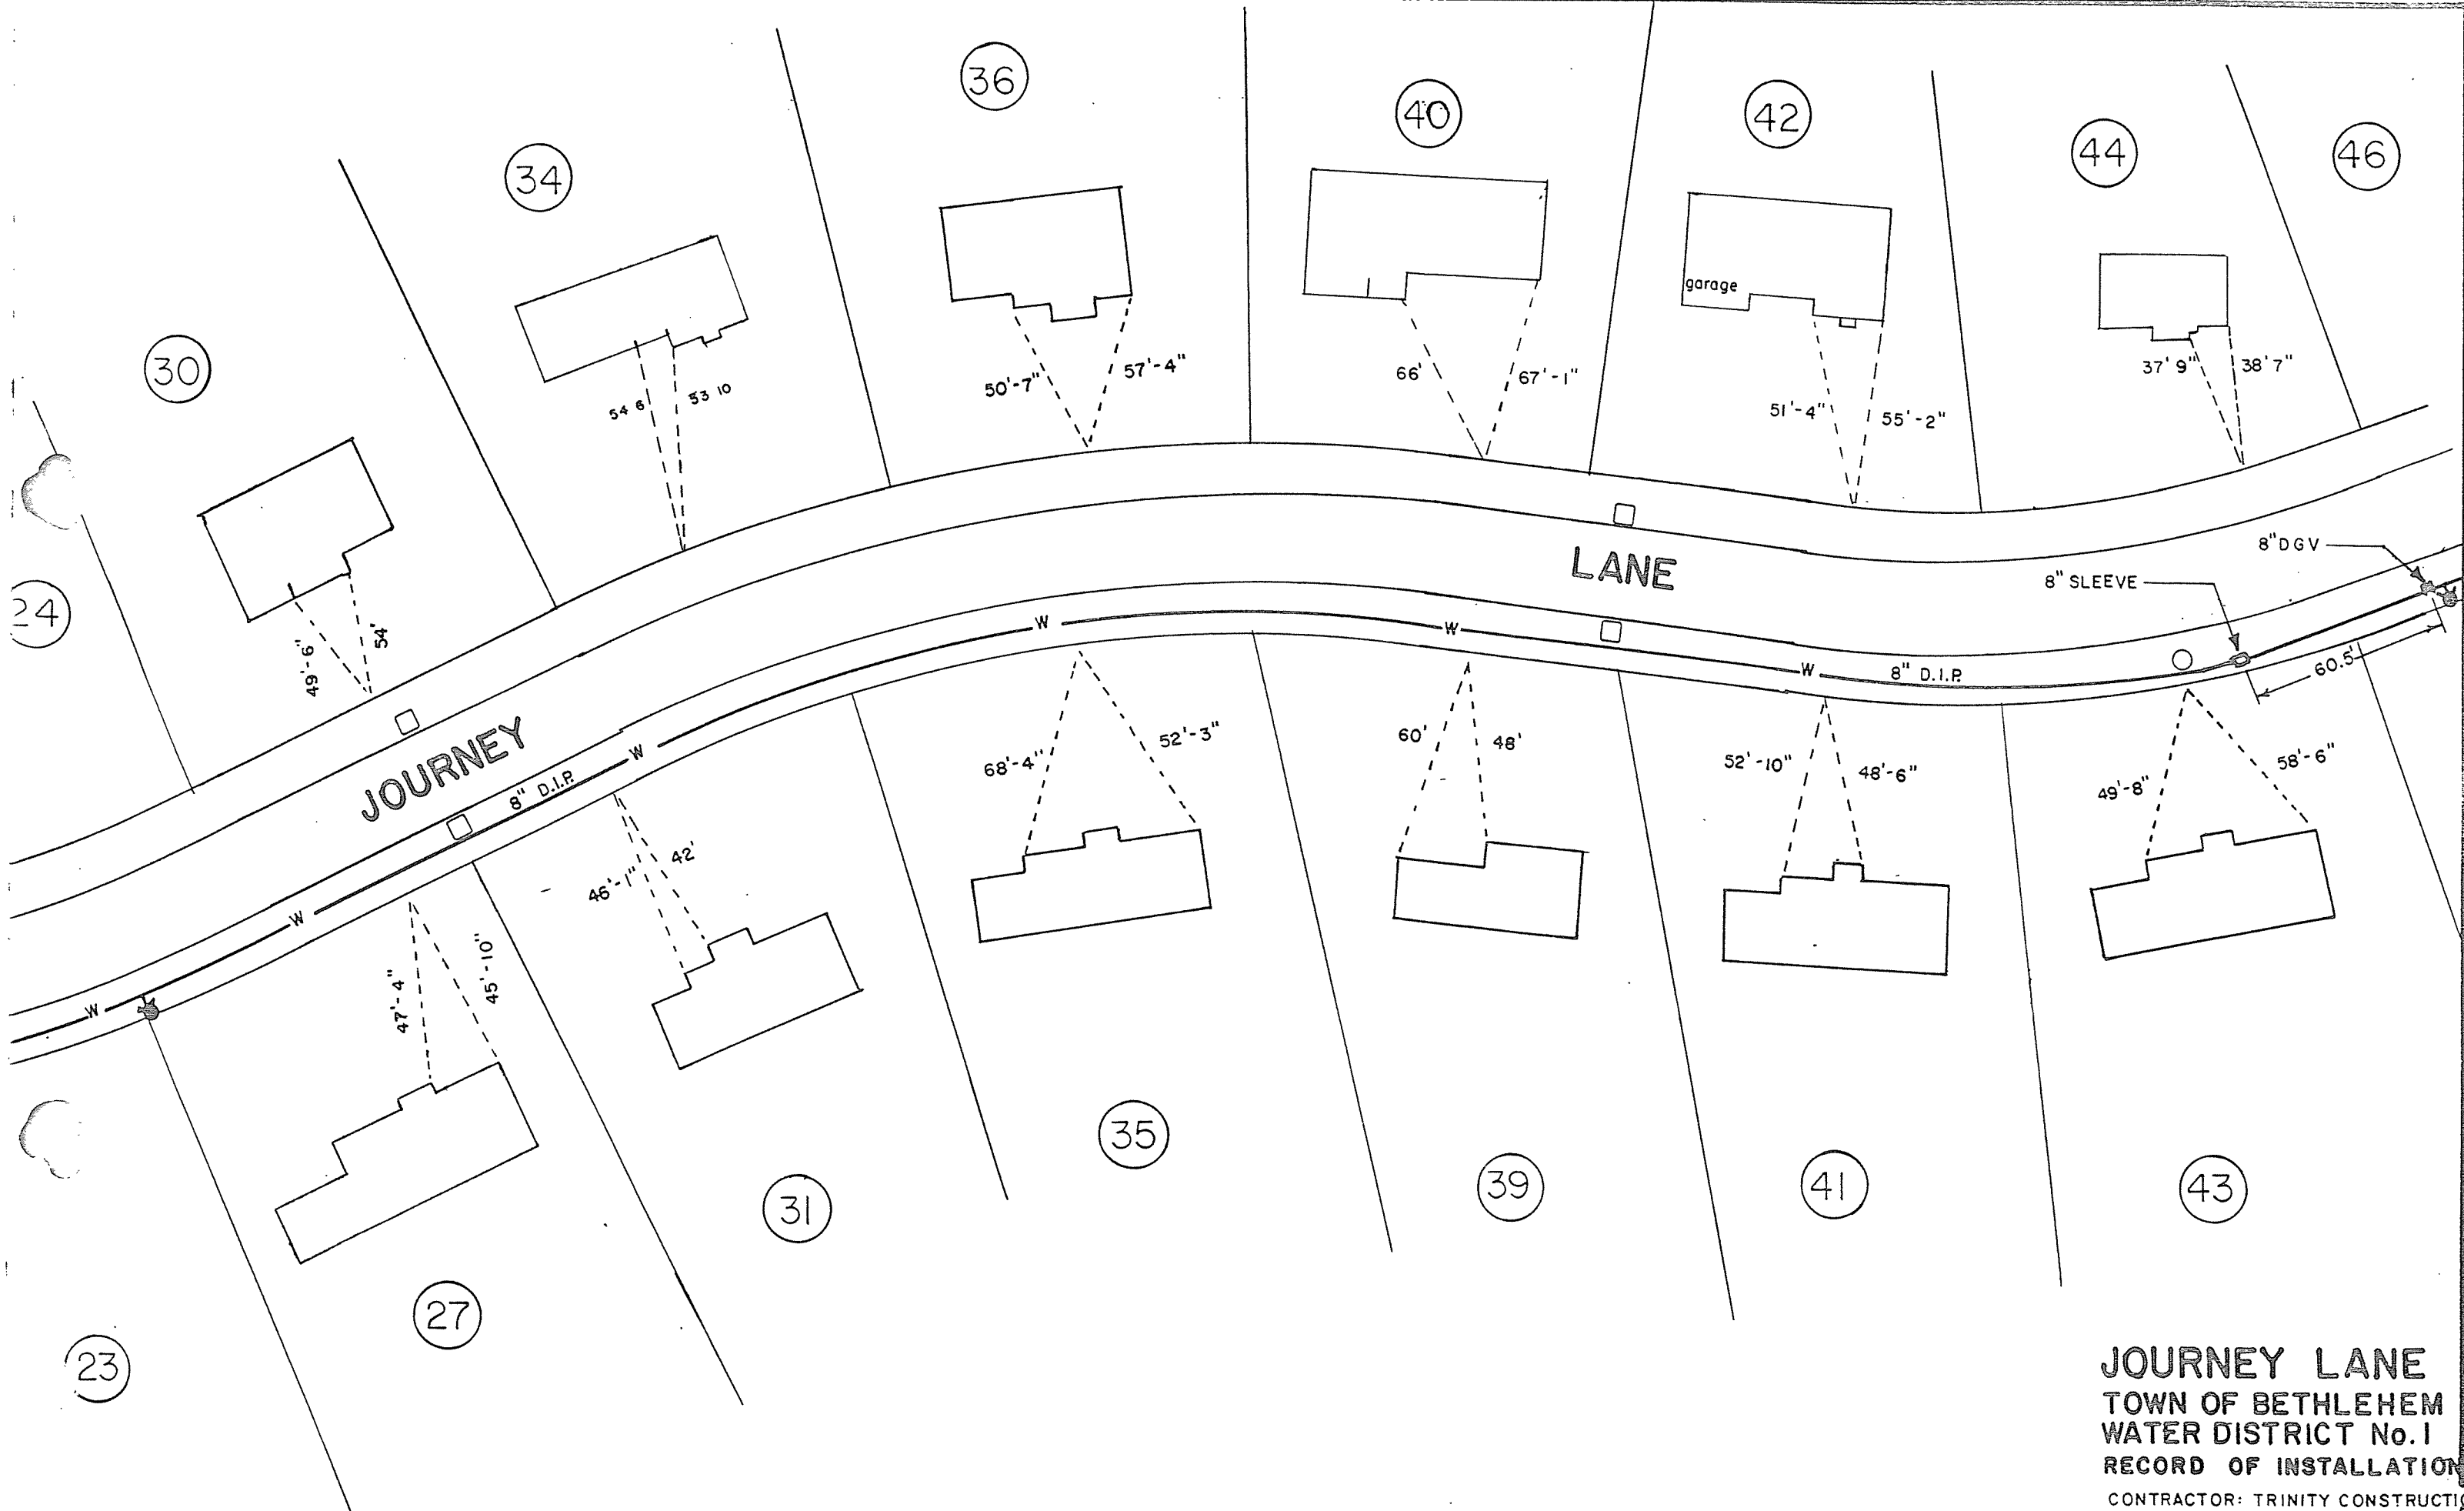

JOURNEY LANE
TOWN OF BETHLEHEM
WATER DISTRICT No. 1
RECORD OF INSTALLATION
CONTRACTOR: TRINITY CONSTRUCTION
DATE COMPLETED: JUNE 26, 1985
SCALE: 1" = 40'