



CLUSTER "A" 100 SERIES

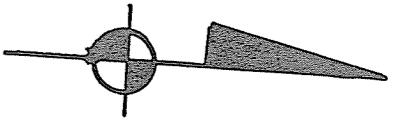

● = 4" x 4" x 2" TEE with Mueller Oriseal Corporation

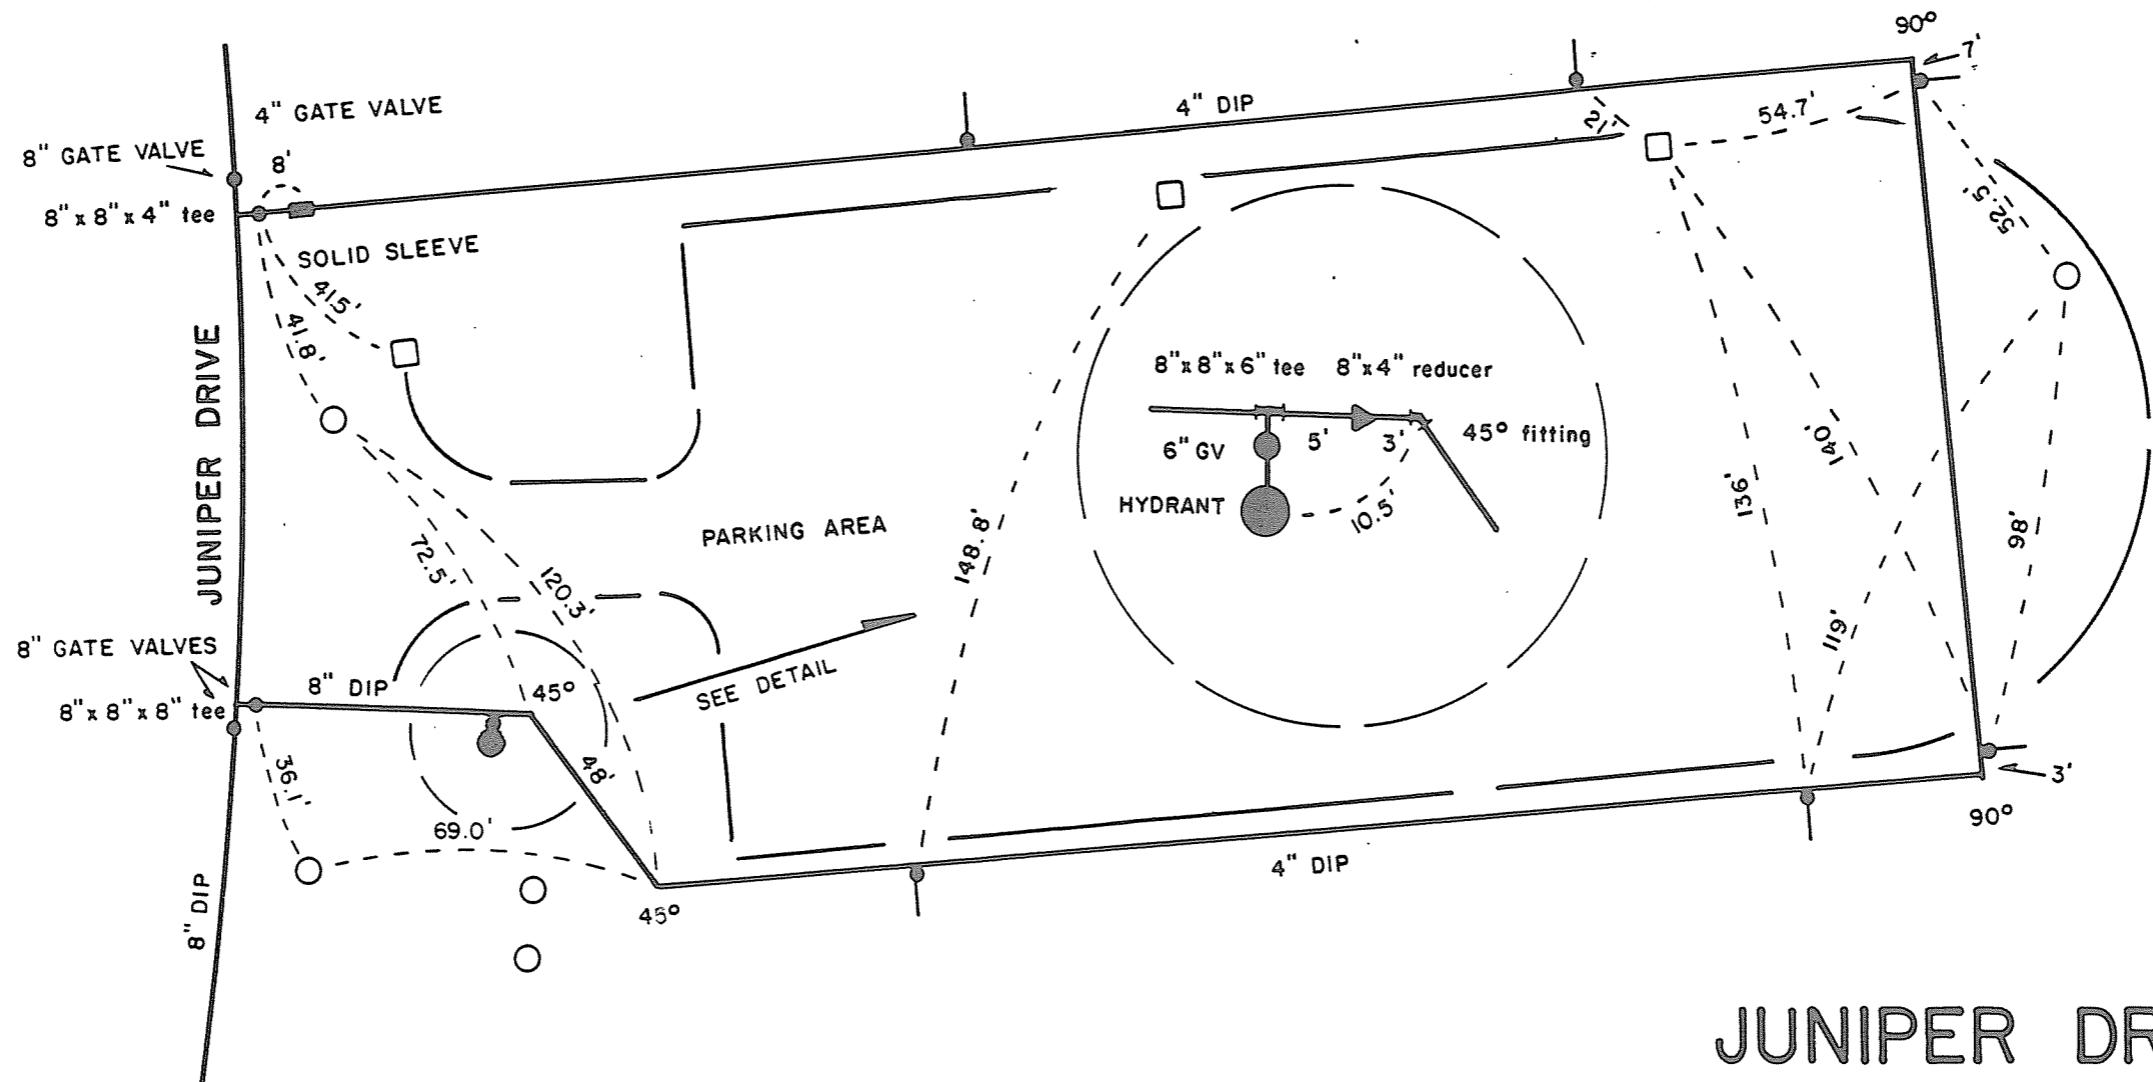

JUNIPER DRIVE

WATER MAIN
OCTOBER 1987

1" = 40'

TWR