
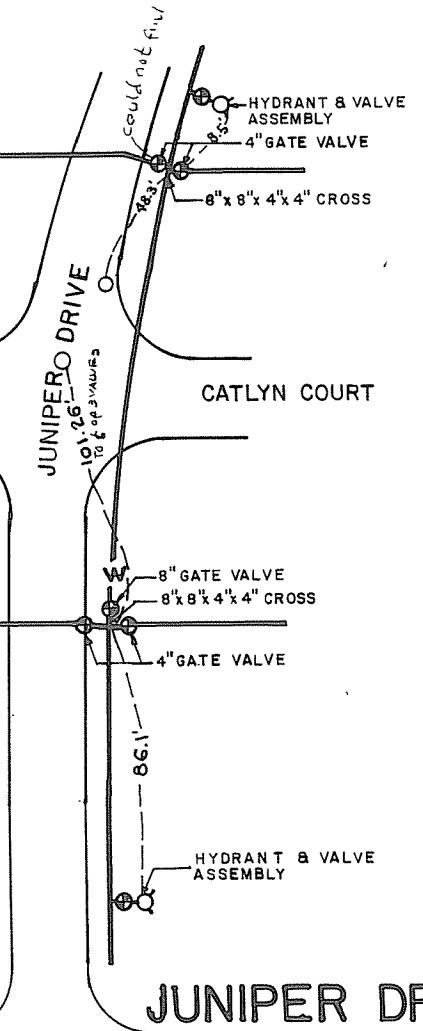


LEGEND

- CATCH BASIN
- MANHOLE
- ◊ HYDRANT
- ⊕ GATE VALVE
- TEE
- ▲ THRUST BLOCK
- W — WATER MAIN

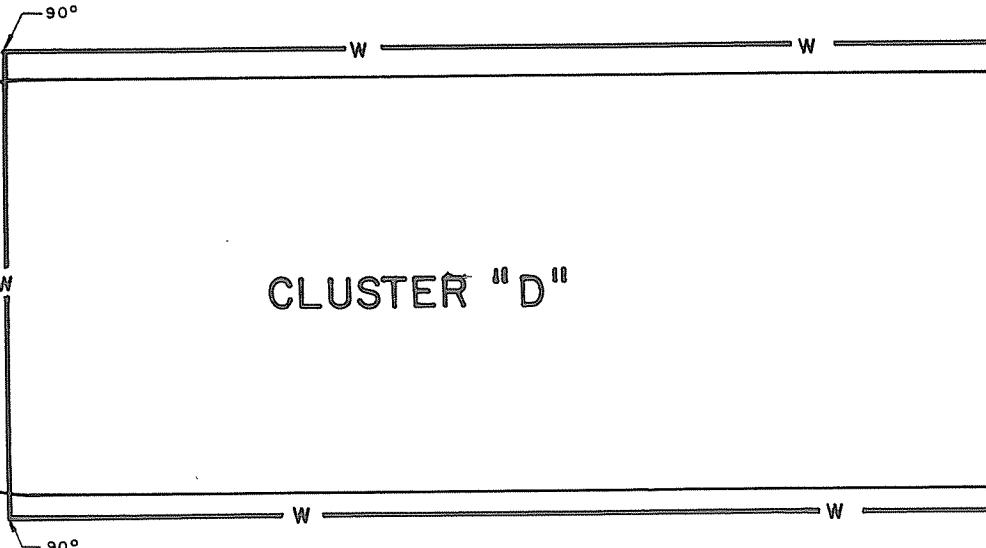

DELMAR BY PASS EXT.

WATER MAIN
OCTOBER 1987
1"=40'