


● = 4" x 2" TEE with Mueller Orisedal Corporation

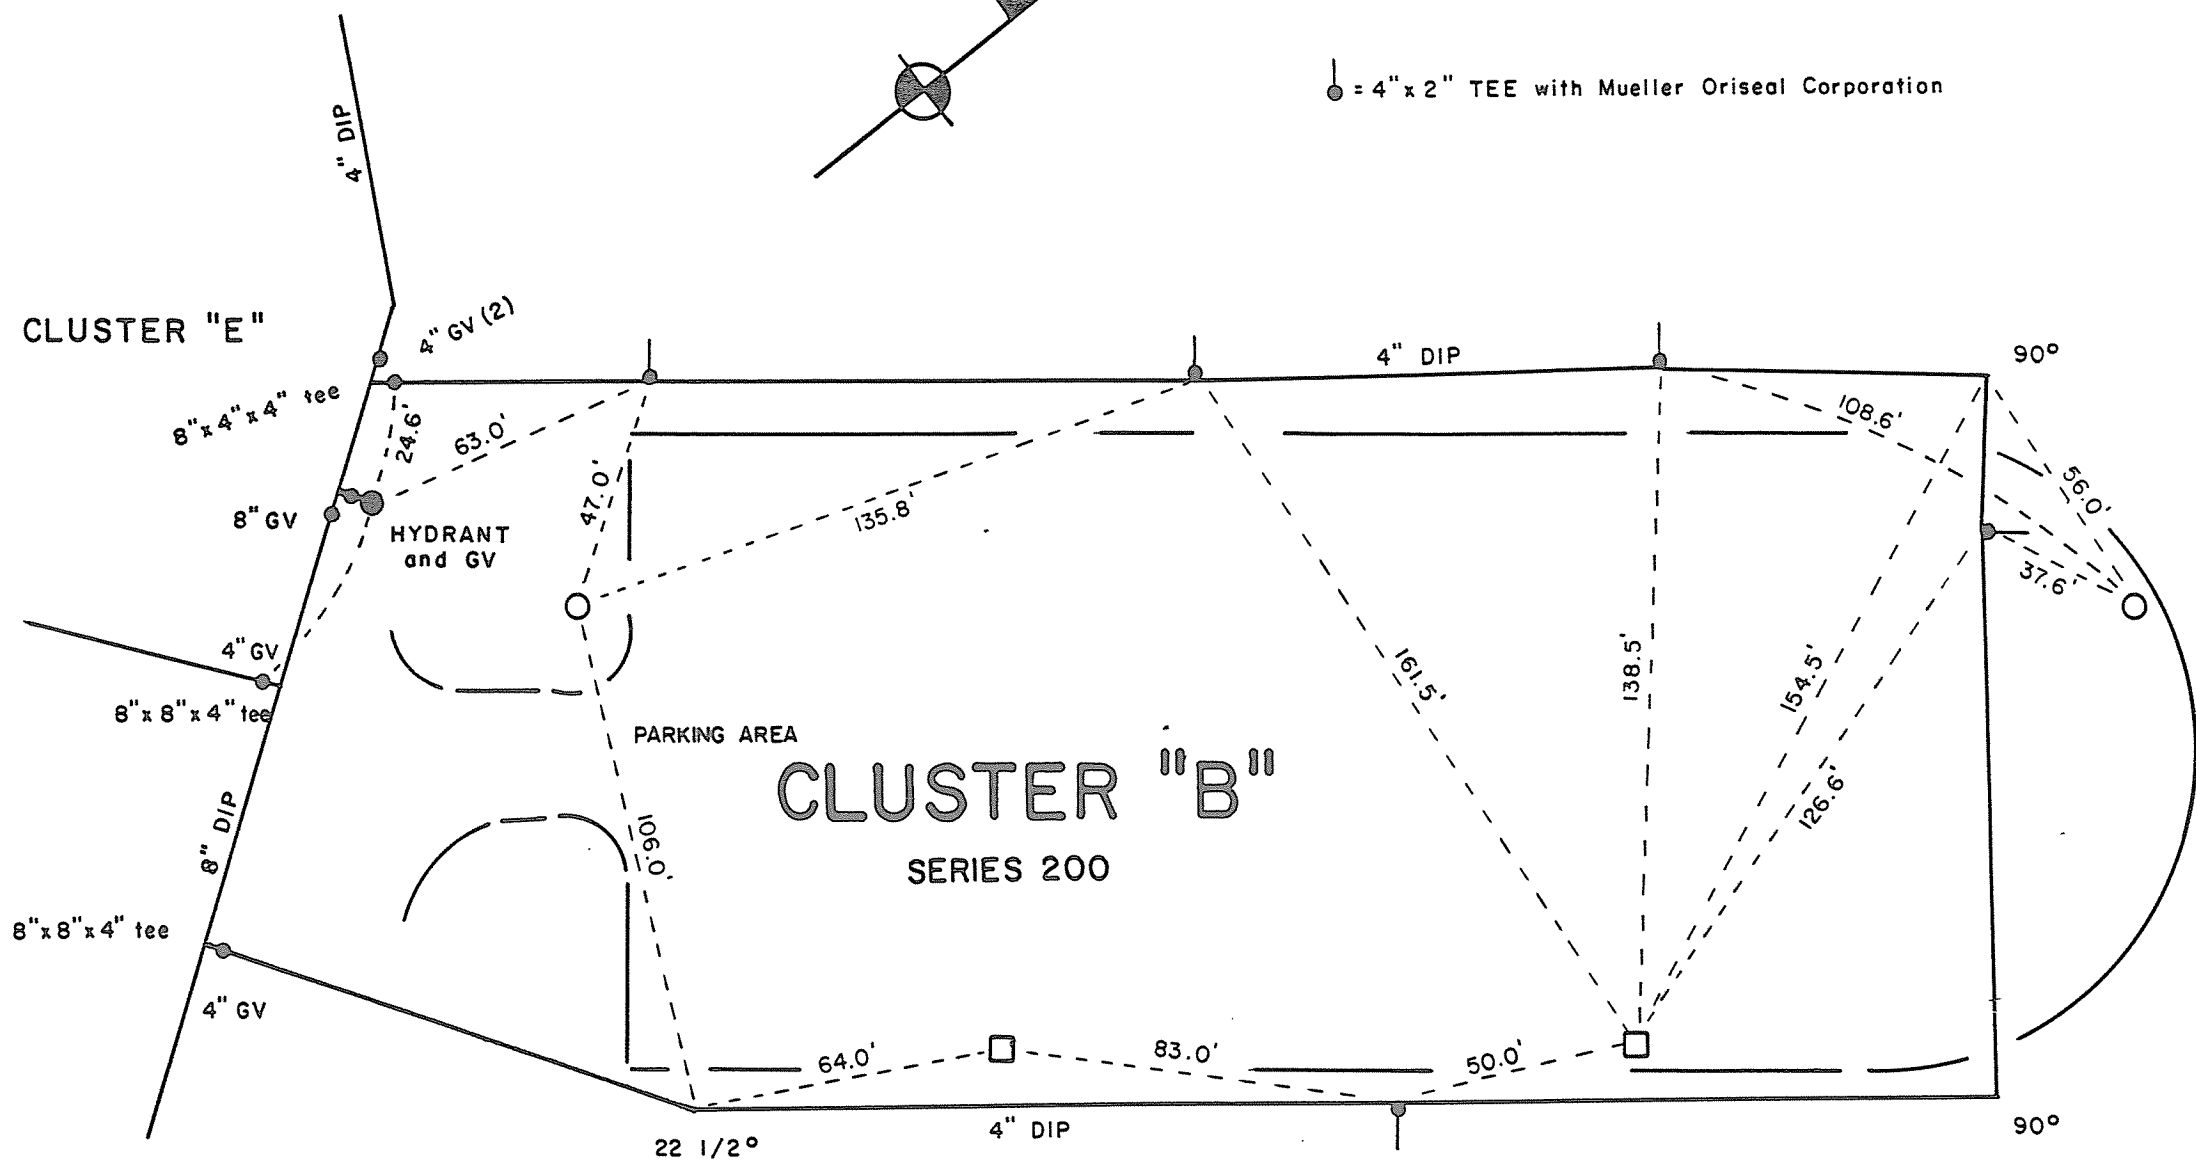

TO JUNIPER DRIVE

JUNIPER DRIVE

WATER MAIN
OCTOBER 1987
1" = 40'

TWR