
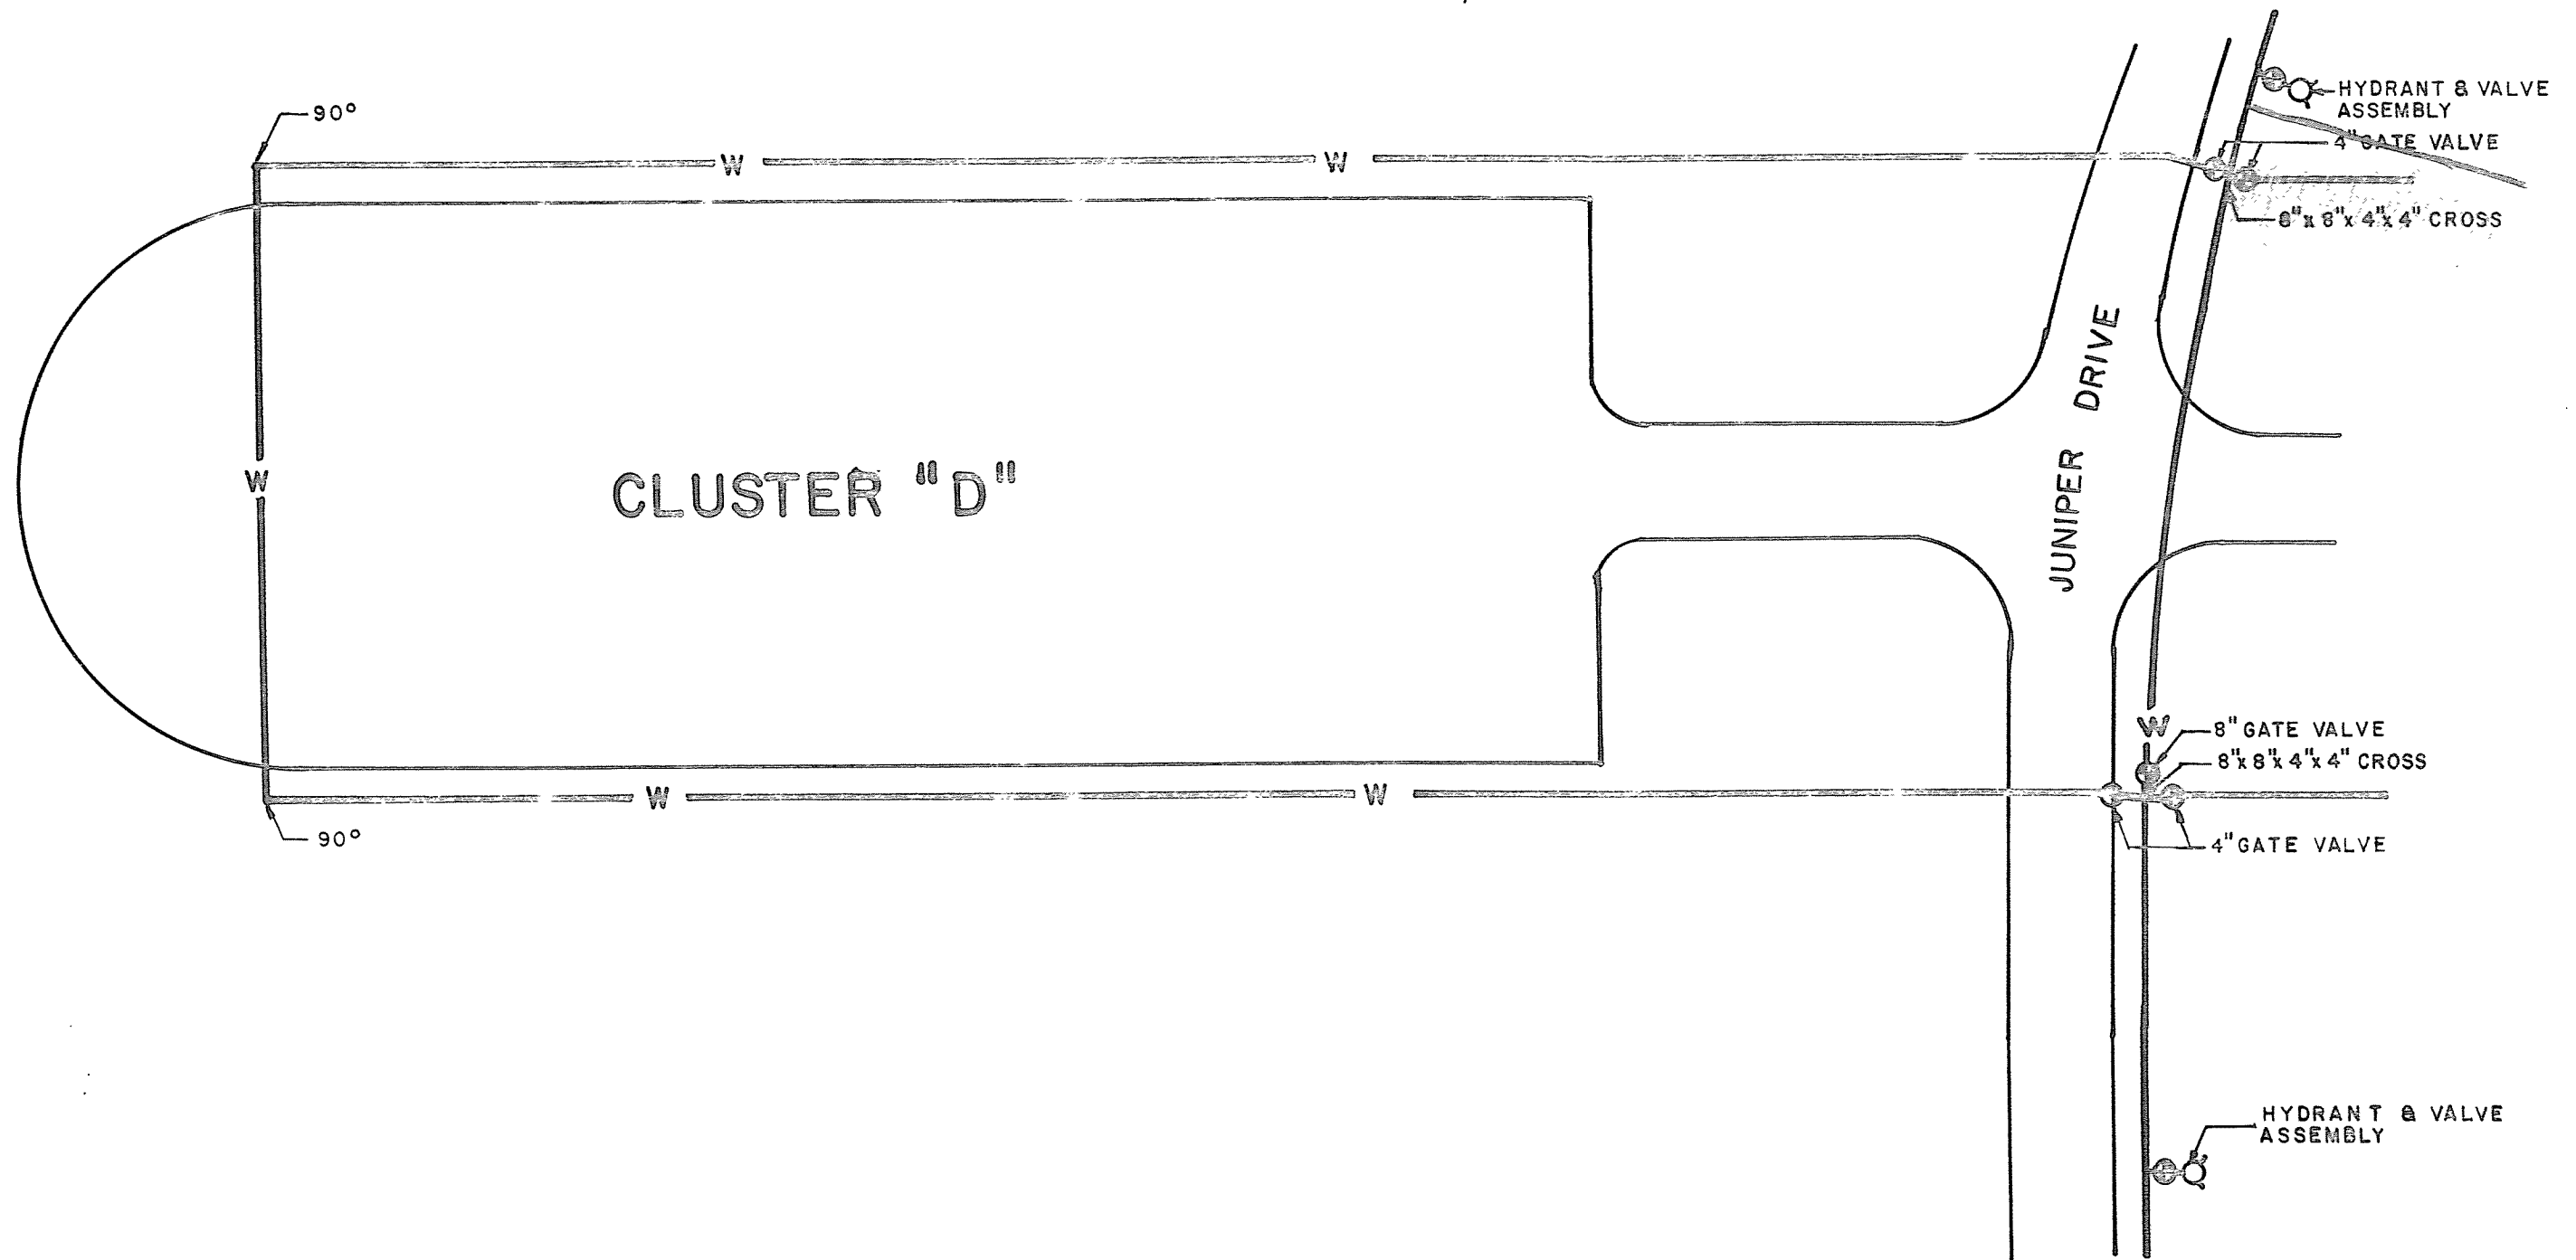


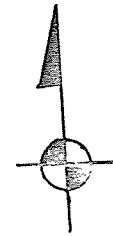

JUNIPER DRIVE

WATER MAIN
OCTOBER 1987
1" = 40'