


LEGEND

- CATCH BASIN
- MANHOLE
- HYDRANT
- GATE VALVE
- ⊥ TEE
- ▲ THRUST BLOCK
- W— WATER MAIN

○ = 4" x 2" TEE with Mueller Oriseal Corporation

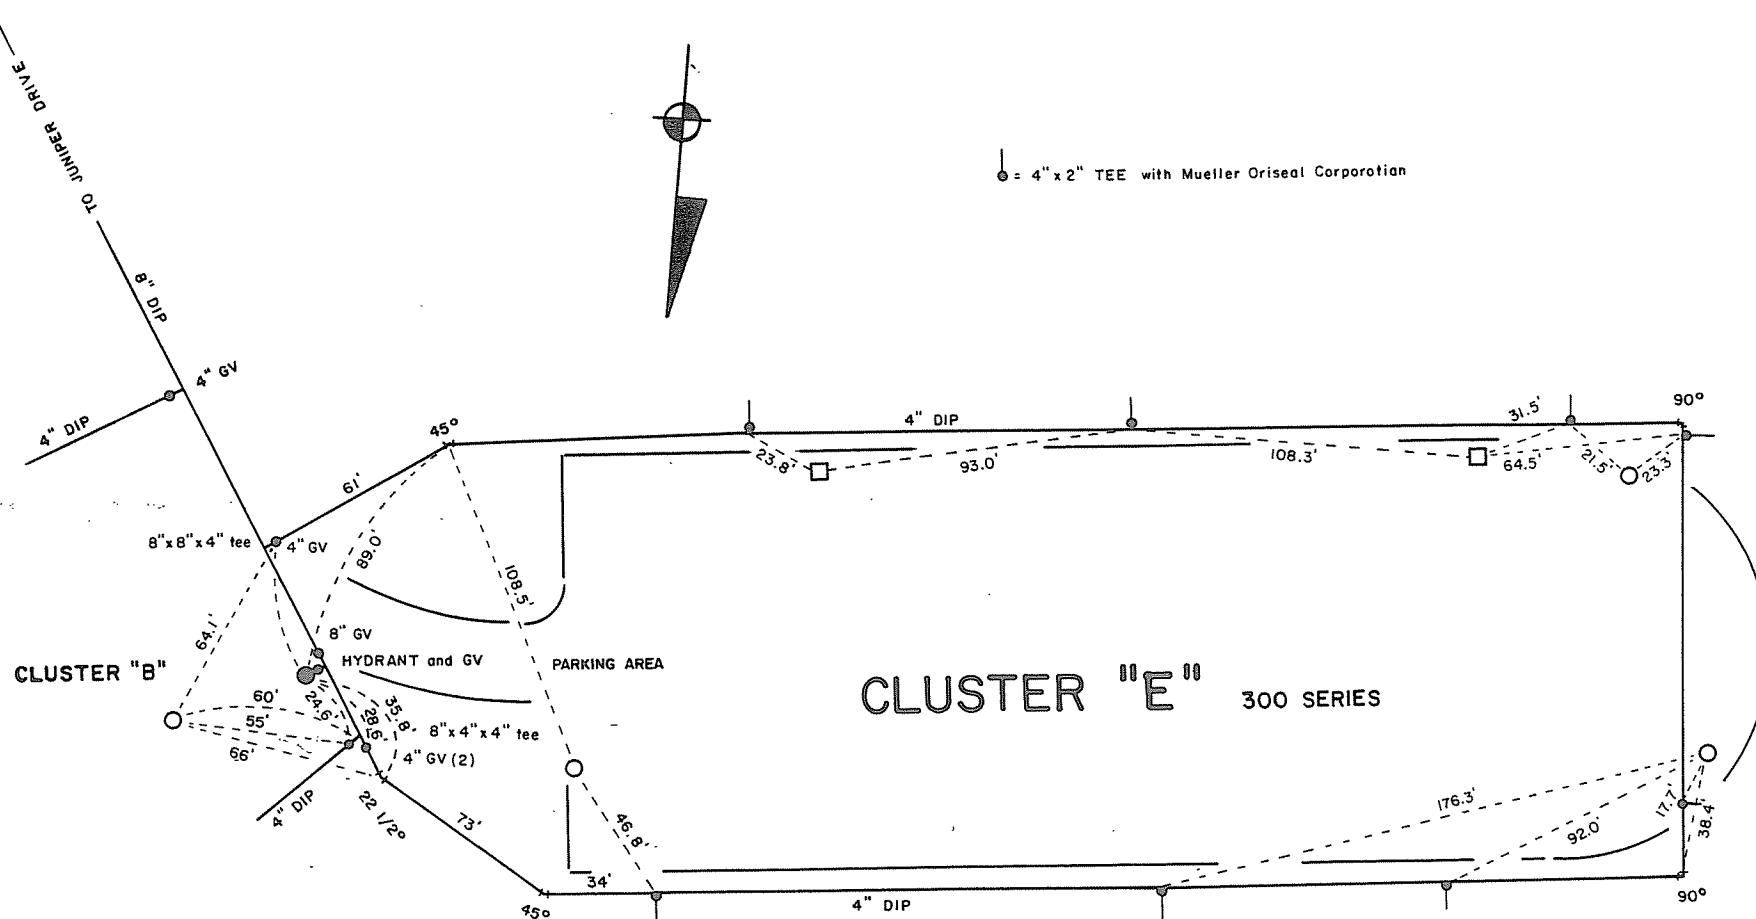

JUNIPER DRIVE

WATER MAIN
OCTOBER 1987
1" = 40'

TWR