


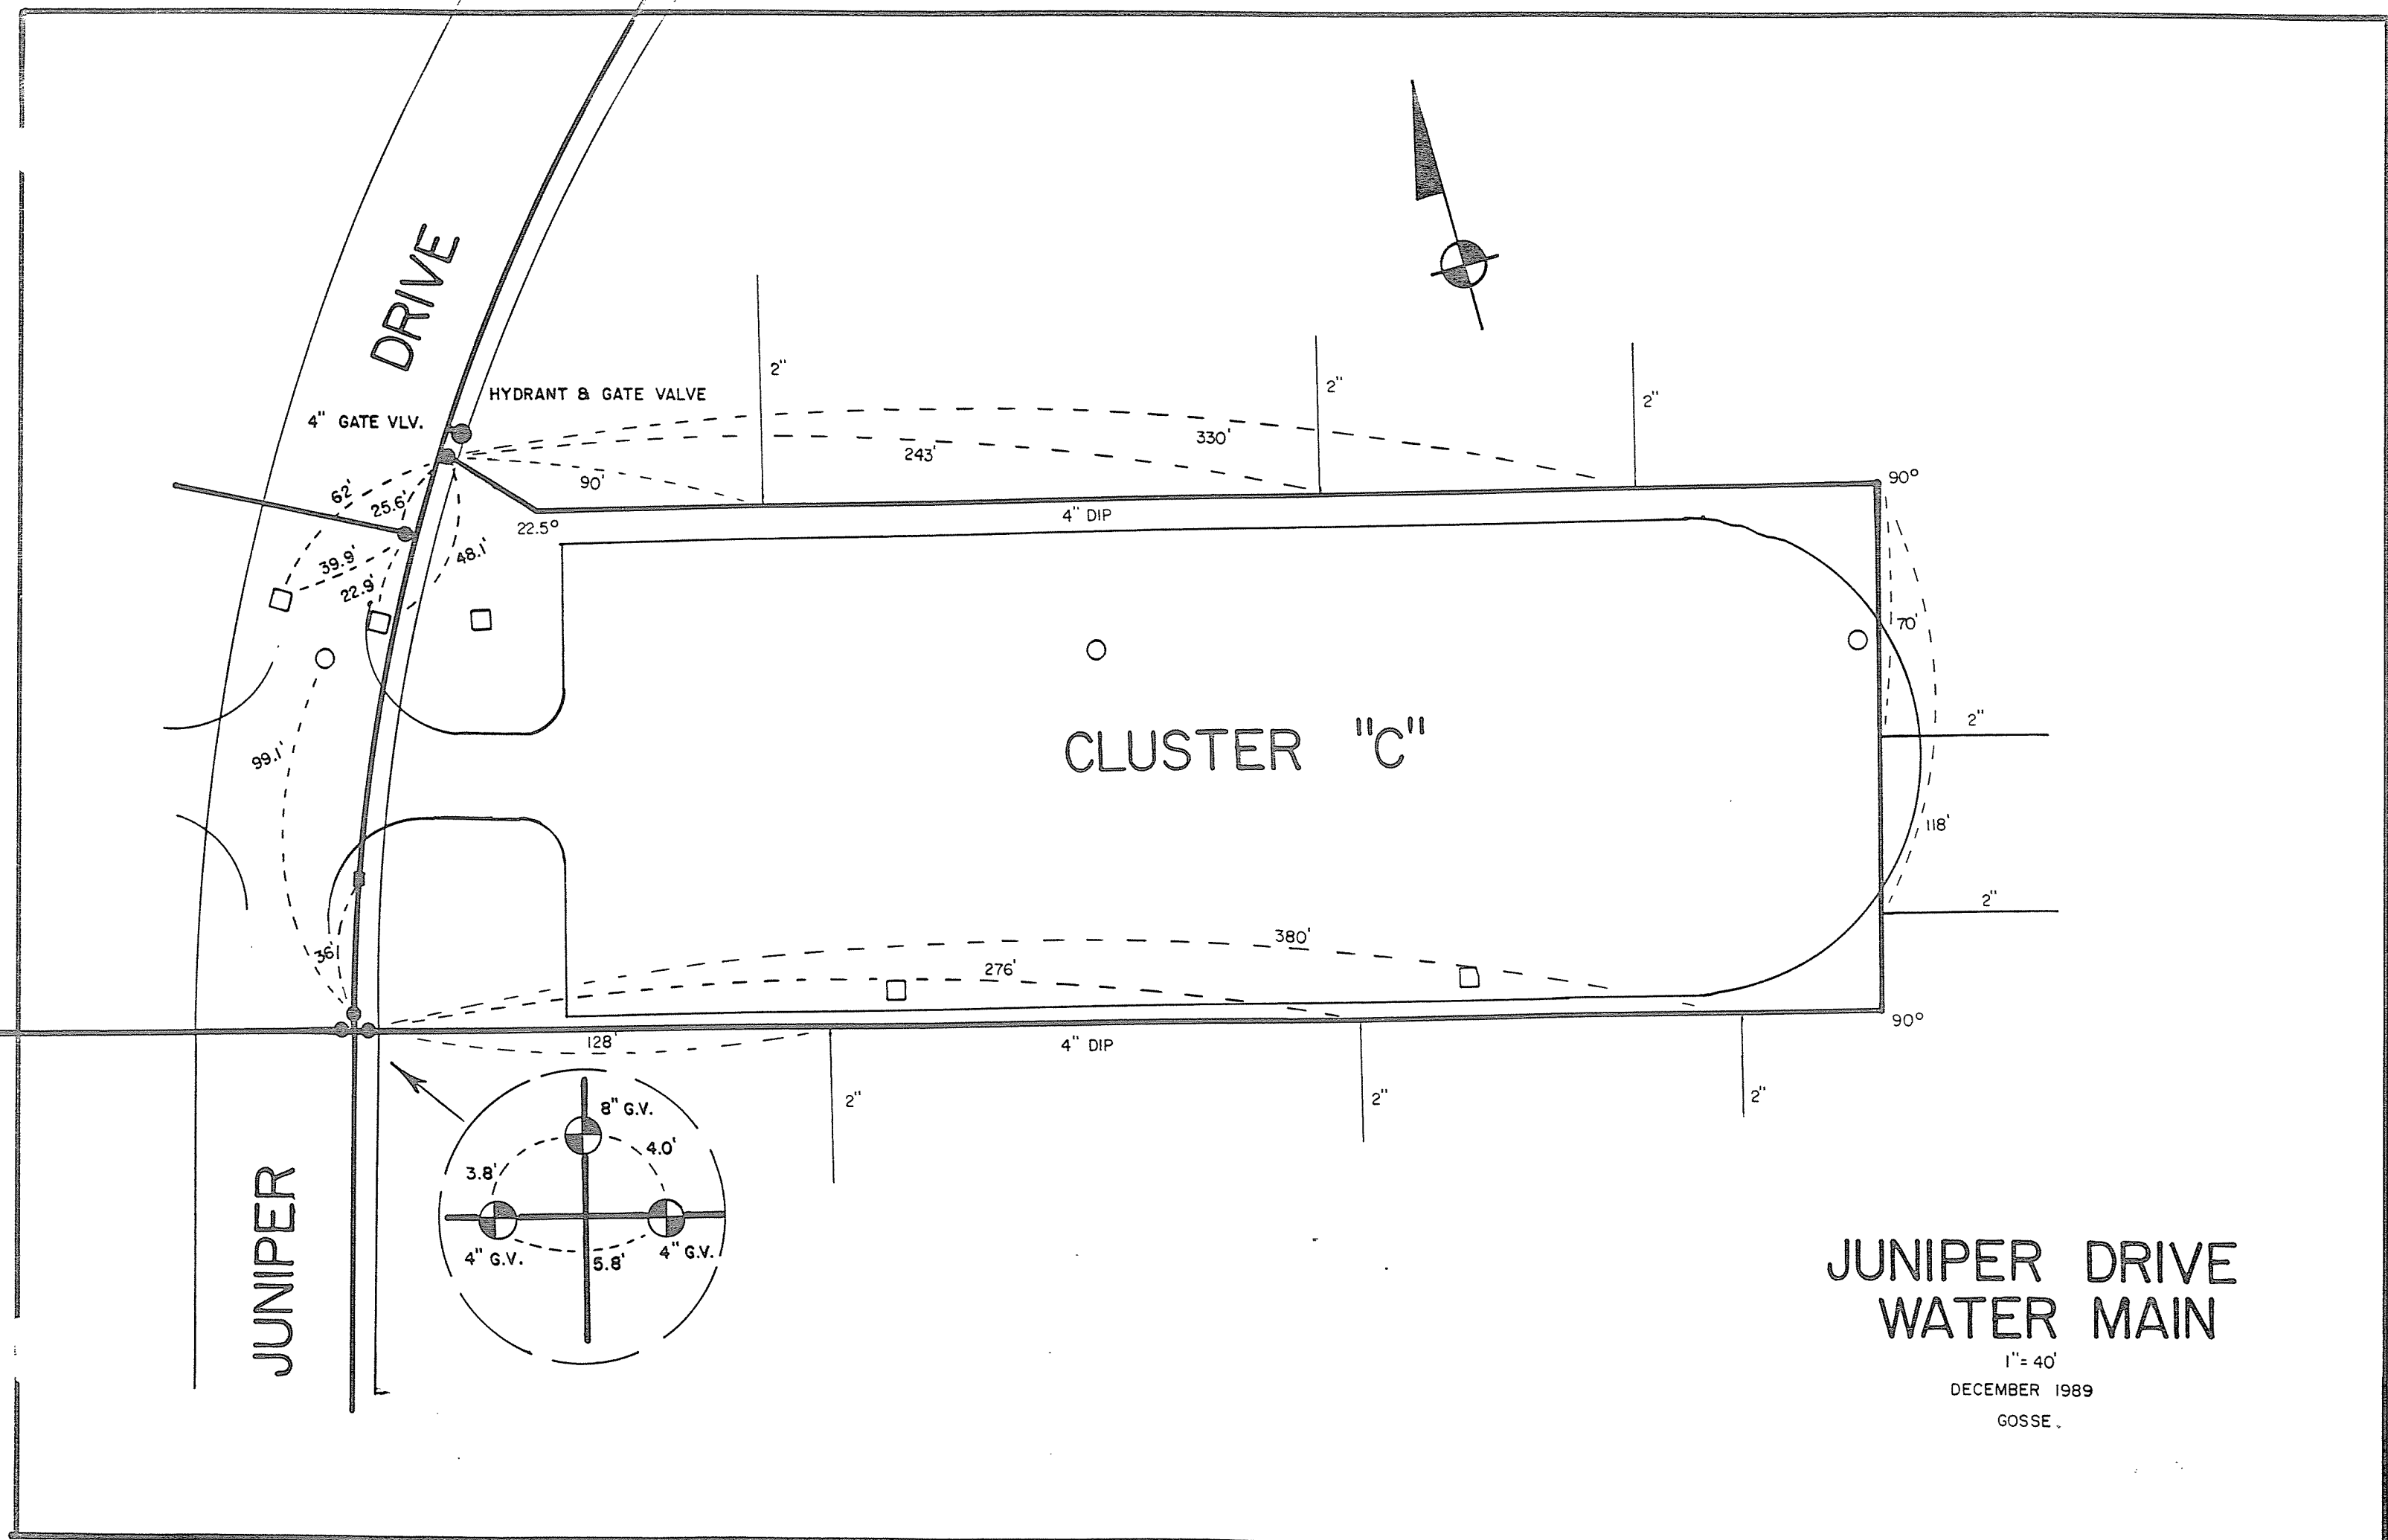

JUNIPER DRIVE
WATER MAIN

1" = 40'
DECEMBER 1989
GOSSE