
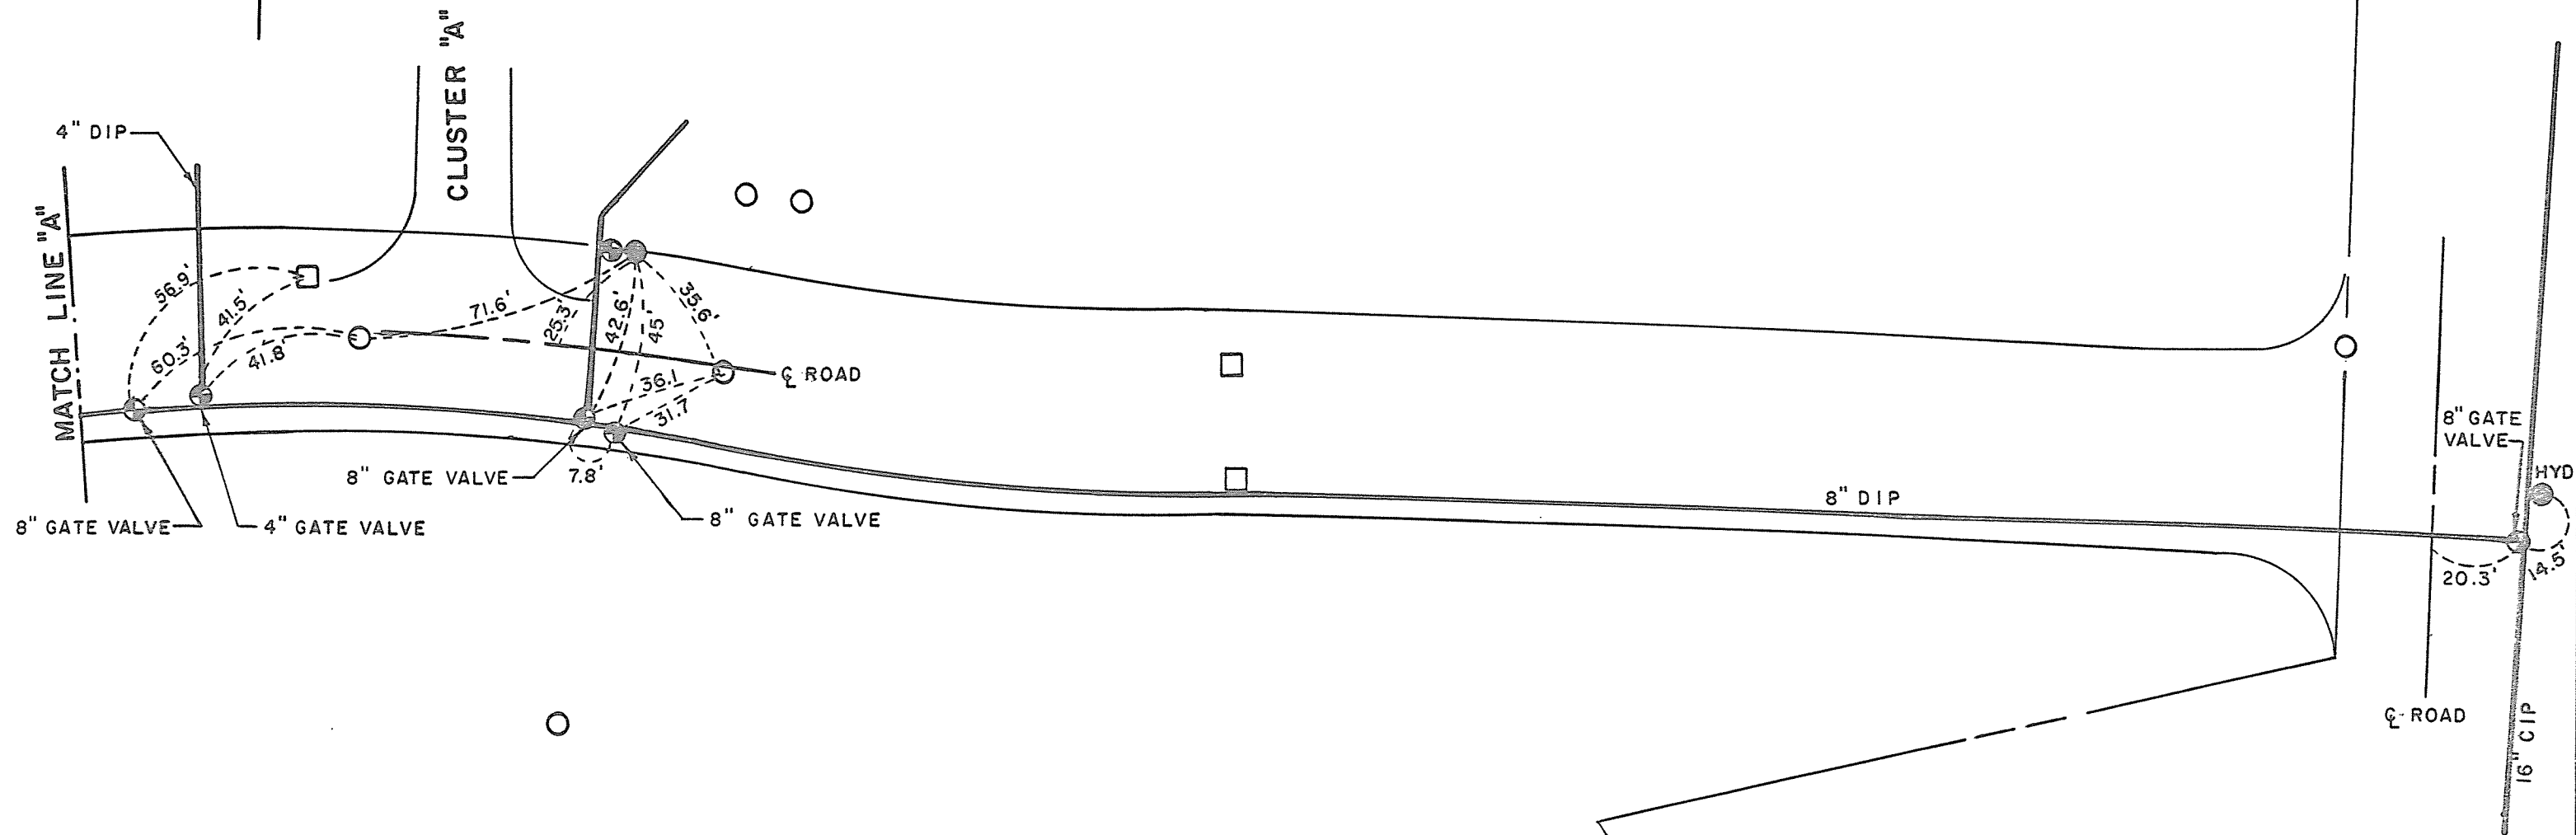


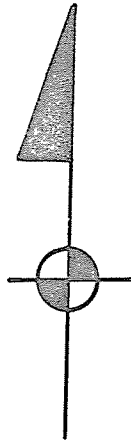

JUNIPER DRIVE

WATER MAIN

10/87

1" = 40'