


LEGEND

- CATCH BASIN
- MANHOLE
- ⊙ HYDRANT
- ⊕ GATE VALVE
- ⊥ TEE
- ▲ THRUST BLOCK
- W— WATER MAIN

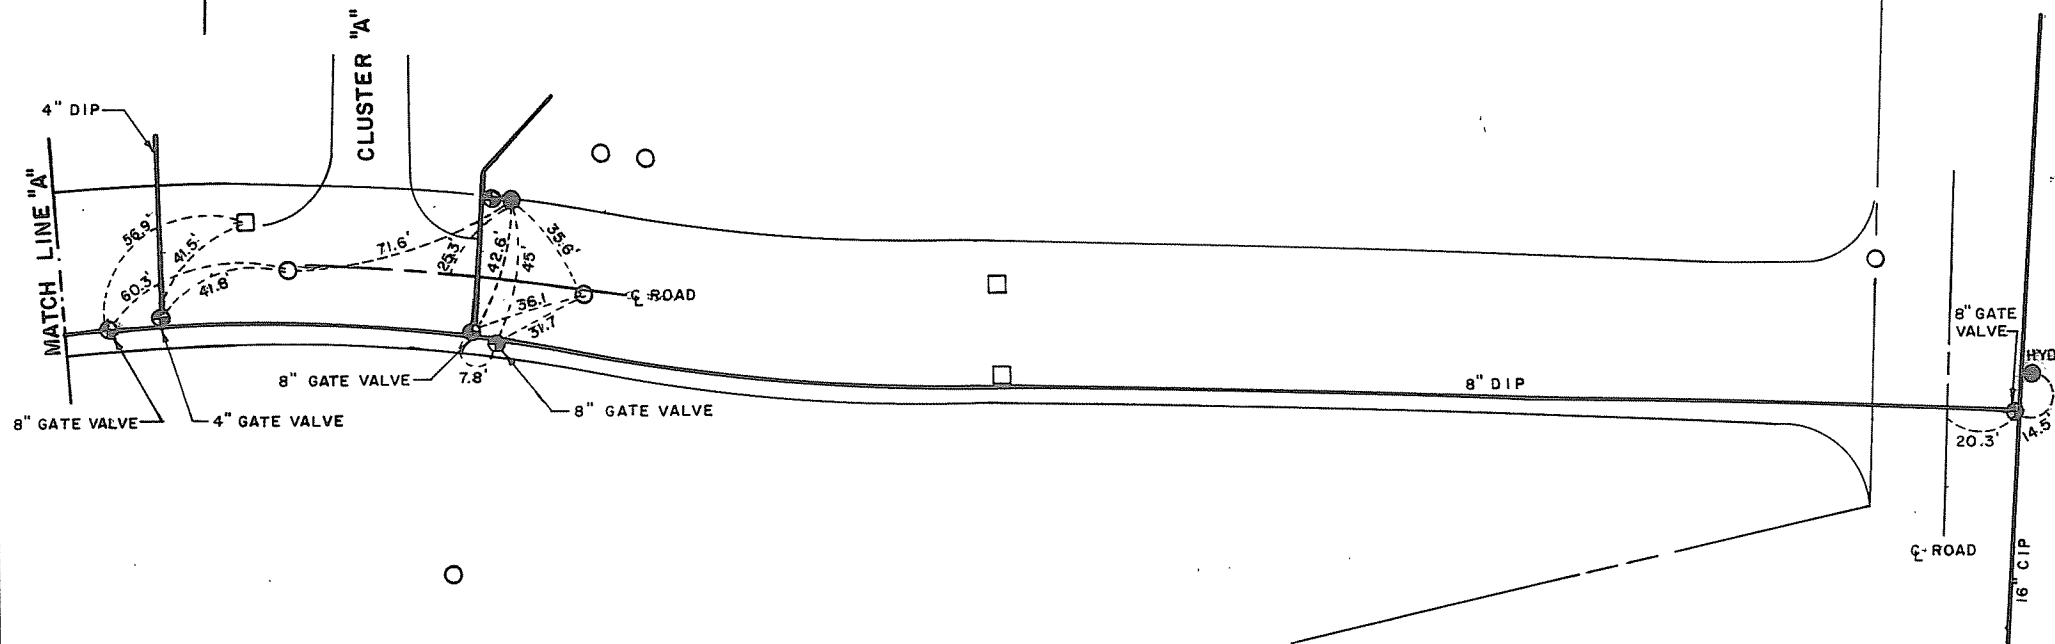

JUNIPER DRIVE

WATER MAIN

10/87

1" = 40'