


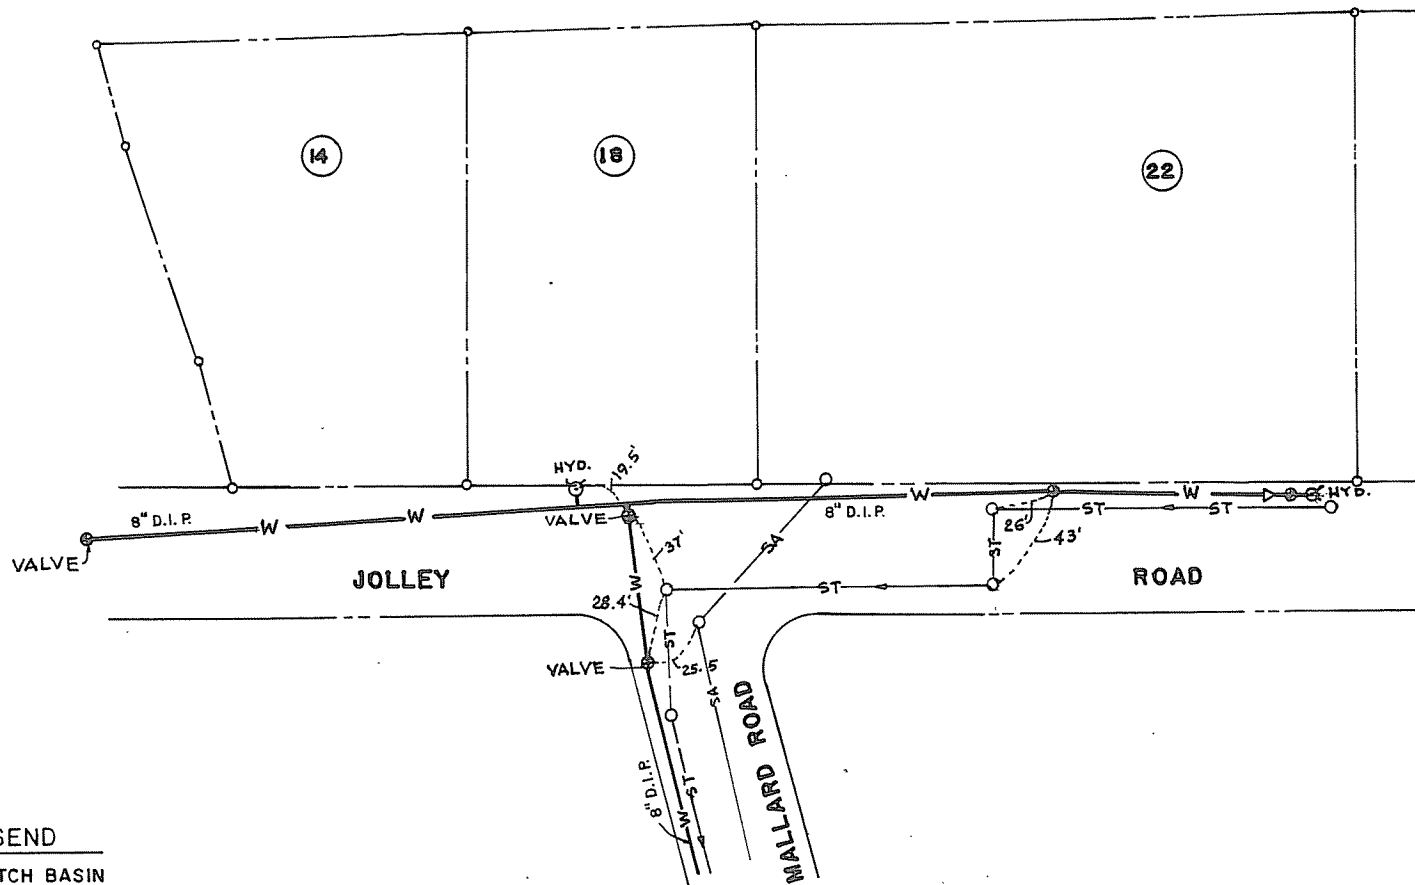

LEGEND

- CATCH BASIN
- MANHOLE
- ⊕ HYDRANT
- ⊗ GATE VALVE
- T TEE
- ▲ THRUST BLOCK
- W — WATER MAIN
- SA — SANITARY SEWER
- ST --- STORM SEWER

COUNTY
ALBANY

DATE
NOV. 19, 1996

REVISION

JOLLEY ROAD WATER MAIN

STATE
NEW YORK

SCALE
1" = 50'



TOWN OF BETHLEHEM
ENGINEERING DIVISION
445 Delaware Ave. Delmar, New York 12054

DRAWING NO.