


LEGEND

- CATCH BASIN
- MANHOLE
- HYDRANT
- ⊕ GATE VALVE
- TEE
- ▲ THRUST BLOCK
- W— WATER MAIN

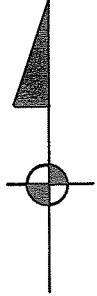

D.M.S.

34°
53.6'

CLUSTER 8" E

16.8'
16.4'
HYD.

MATCH LINE "A"

JUNIPER DRIVE

WATER MAIN

10/87

1" = 40'