
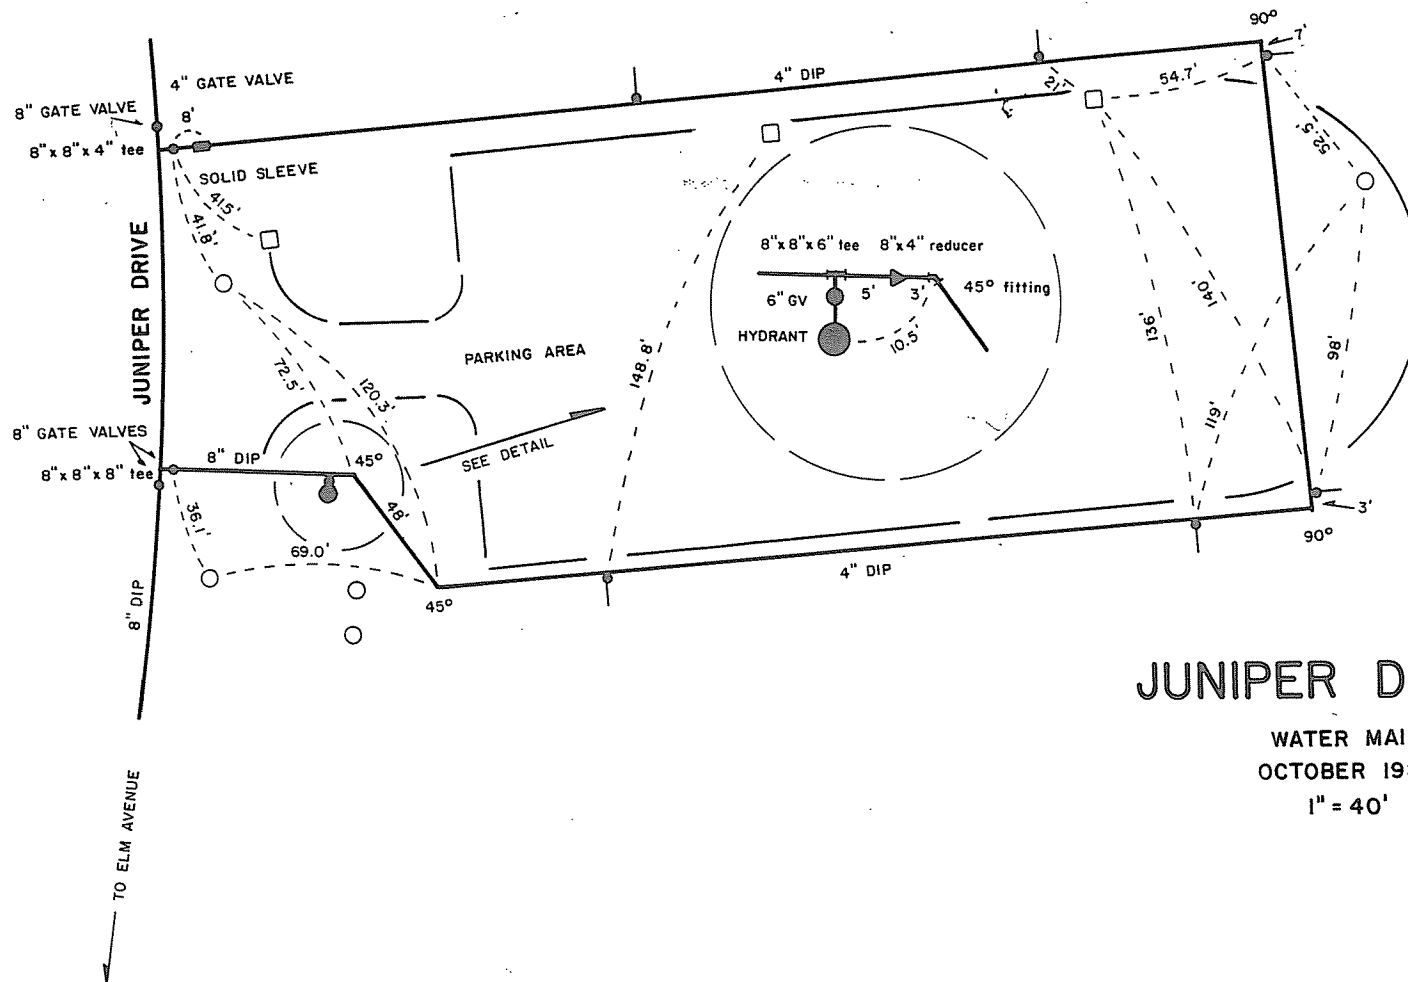


LEGEND

- CATCH BASIN
- MANHOLE
- ⊕ HYDRANT
- ⊙ GATE VALVE
- ⊥ TEE
- △ THRUST BLOCK
- W— WATER MAIN

CLUSTER "A" 100 SERIES

⊥ = 4" x 4" x 2" TEE with Mueller Oriseal Corporation

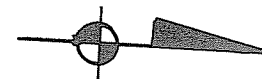

JUNIPER DRIVE

WATER MAIN
OCTOBER 1987
1" = 40'

TWR