


LEGEND

- CATCH BASIN
- MANHOLE
- ⊕ HYDRANT
- GATE VALVE
- ⊥ TEE
- ▲ THRUST BLOCK
- W — WATER MAIN

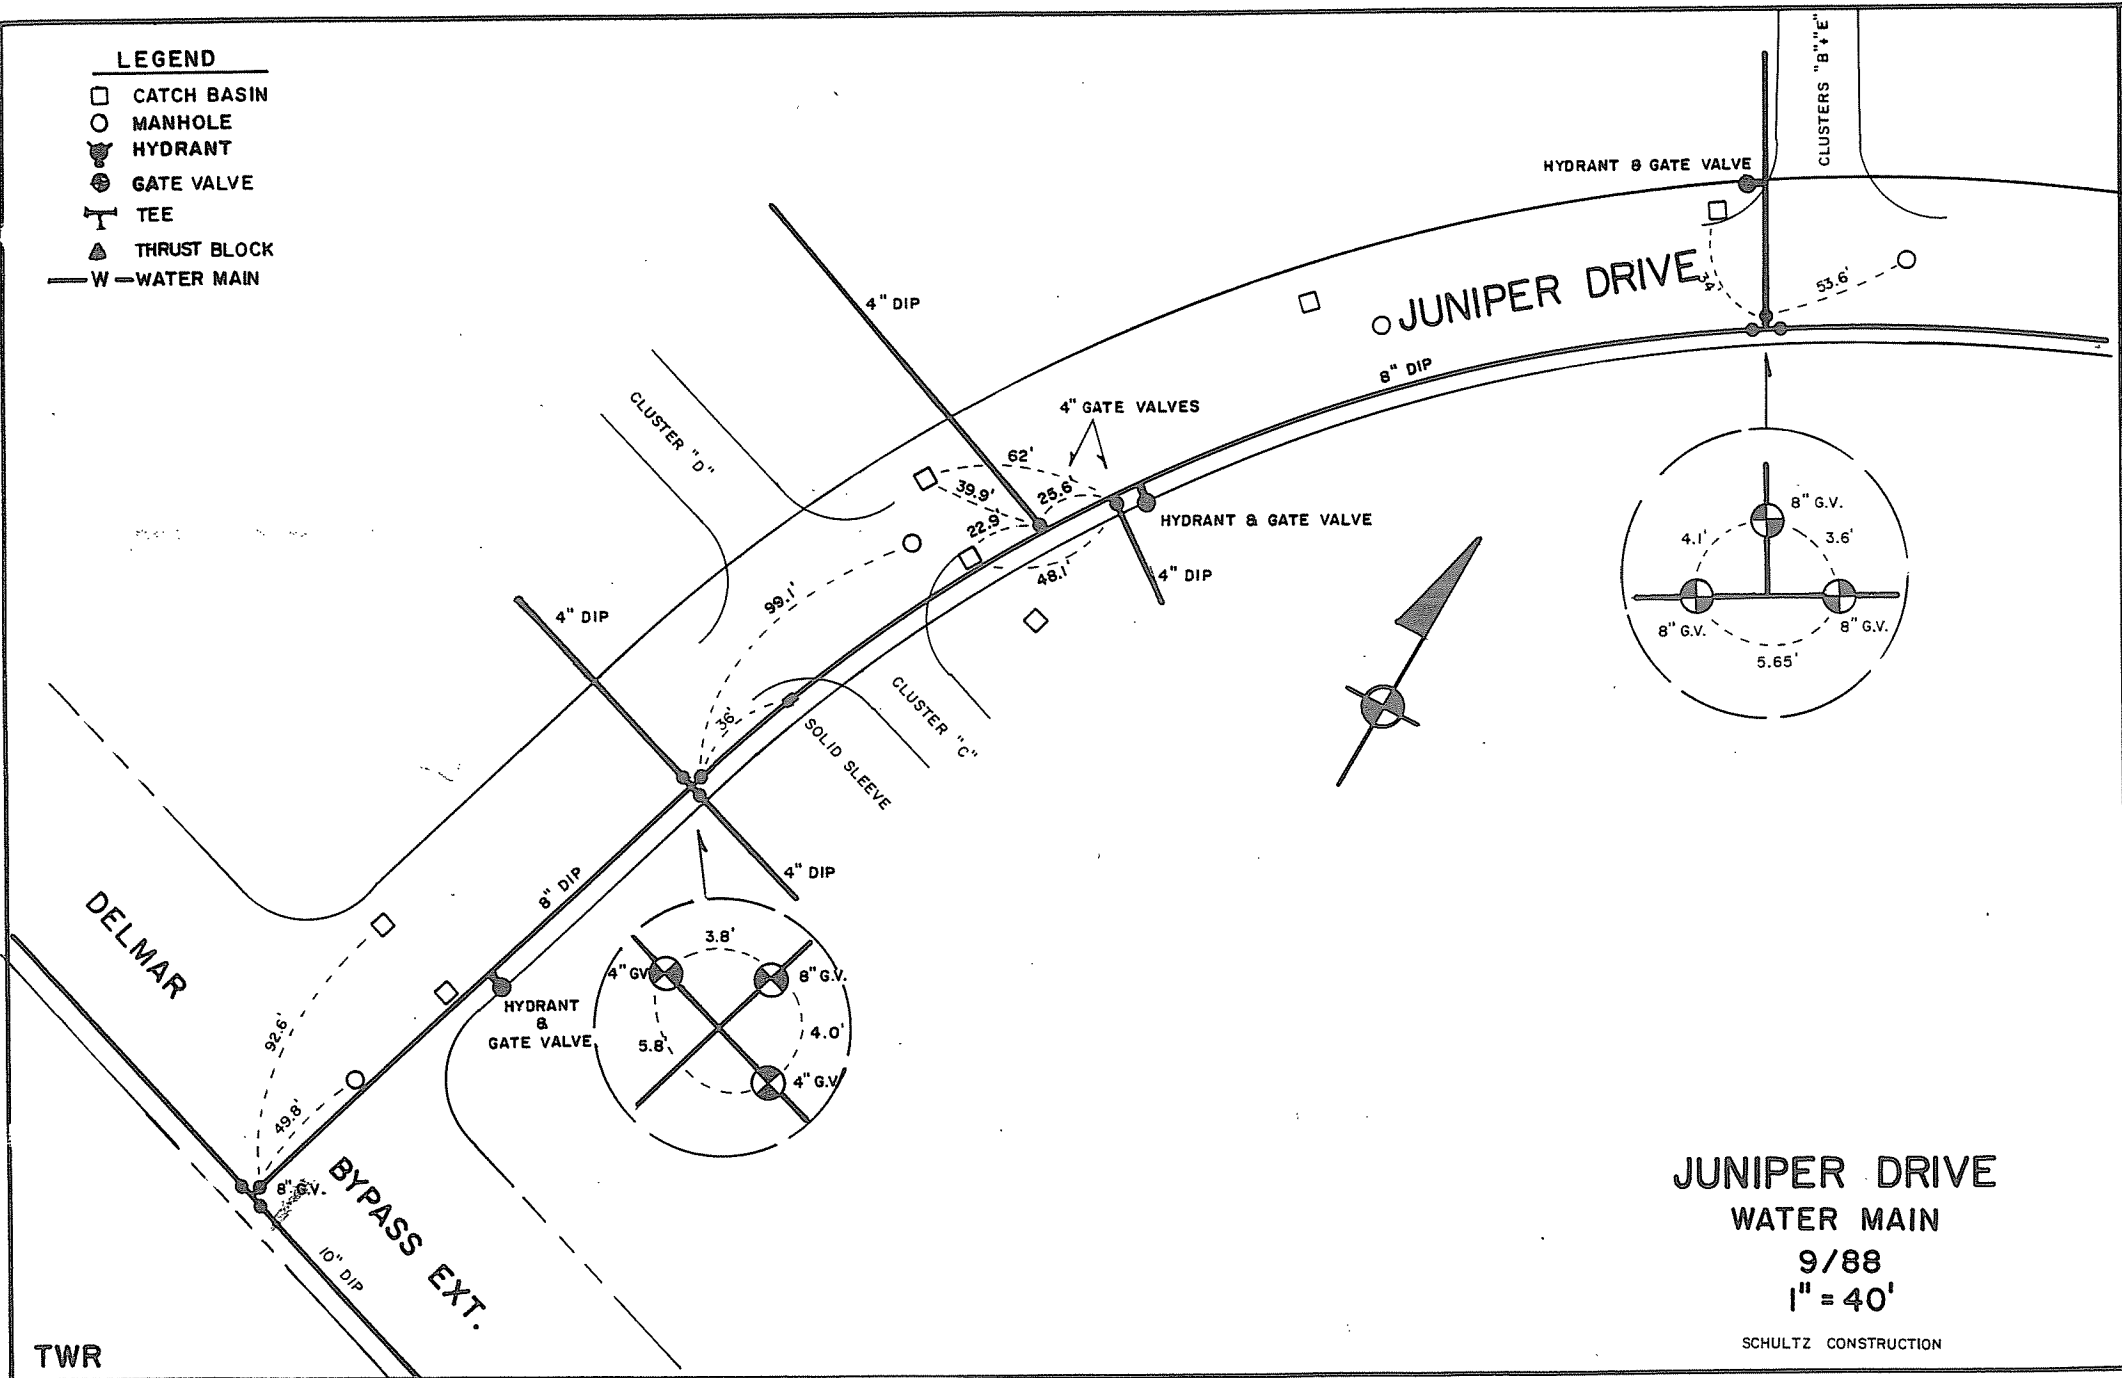

JUNIPER DRIVE

WATER MAIN

9/88

1" = 40'

SCHULTZ CONSTRUCTION

TWR