

KENAWARE AVENUE
"KENAWARE"

WATER DISTRICT NO. 1
TOWN OF BETHLEHEM


RECORD OF INSTALLATION

TOWN OF BETHLEHEM ENGINEERING

DEPARTMENT

SCALE 1"=60' DECEMBER, 1981


DWY BY:PDH

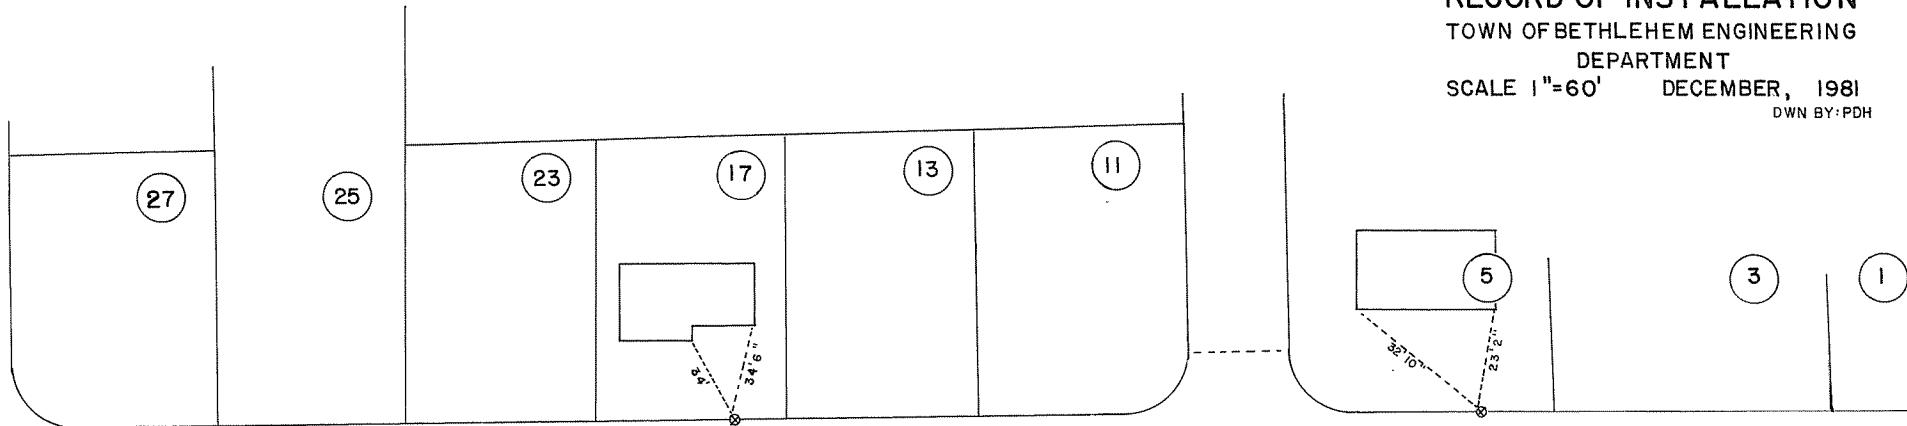

KENAWARE

AVENUE

STRATTON PLACE

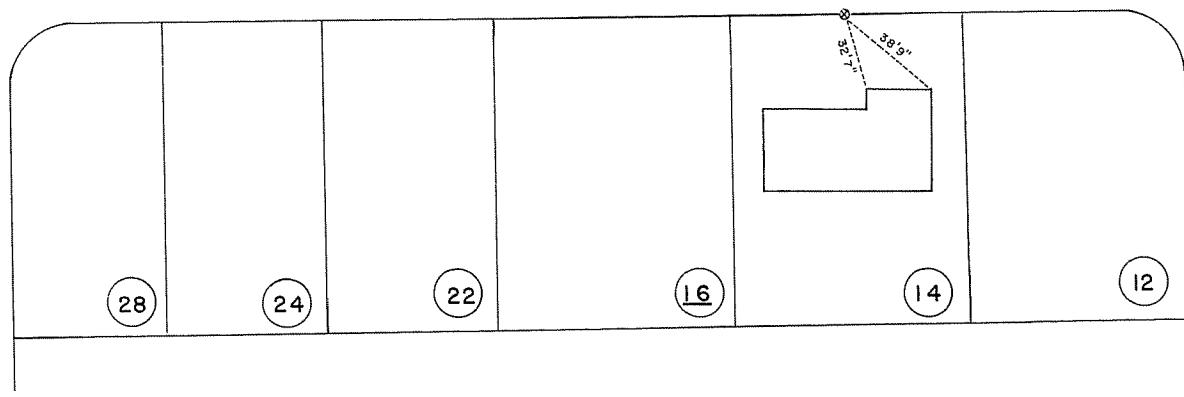

DAWSON ROAD

