
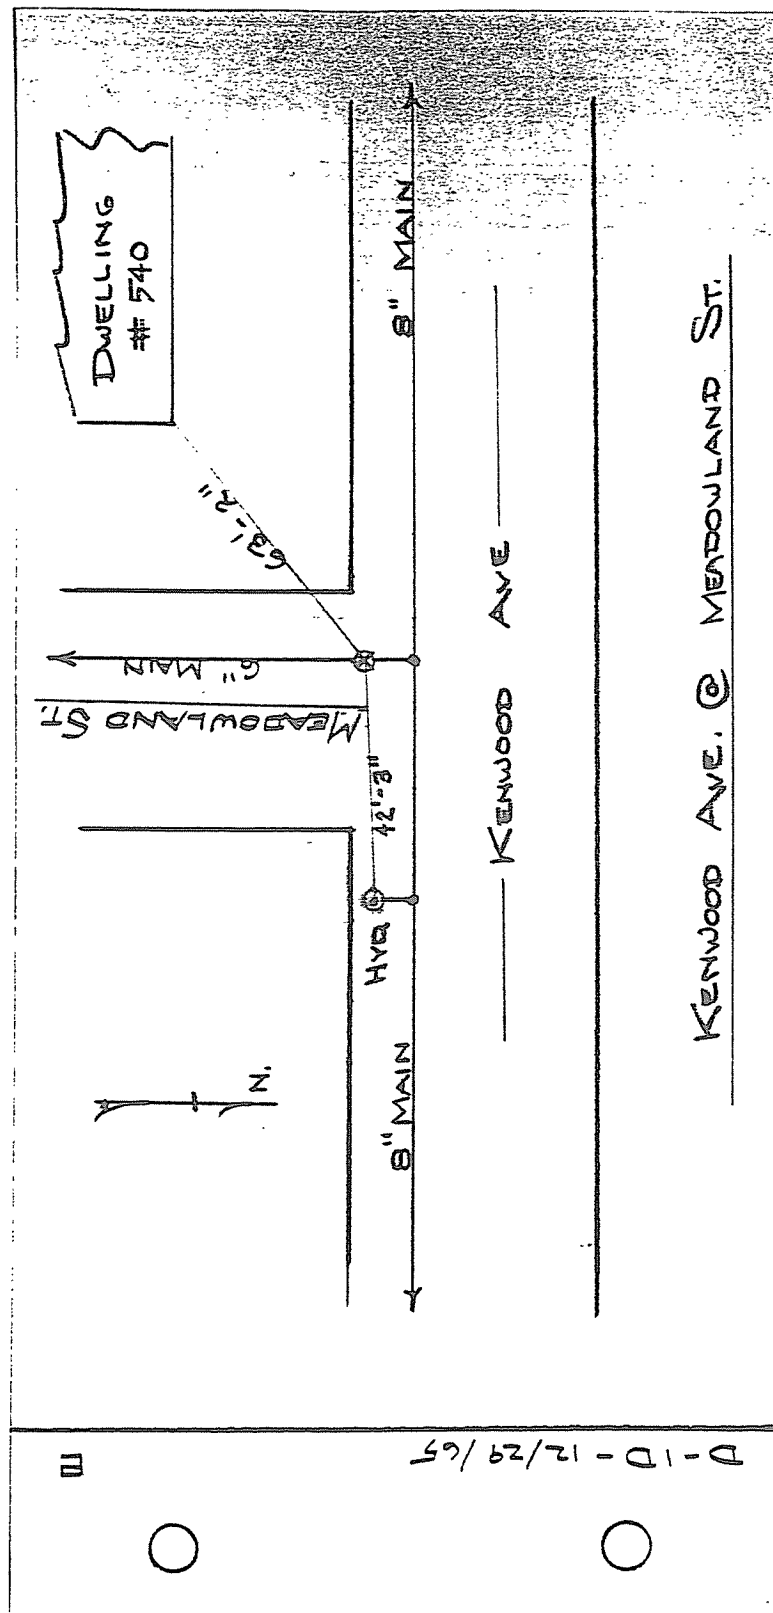
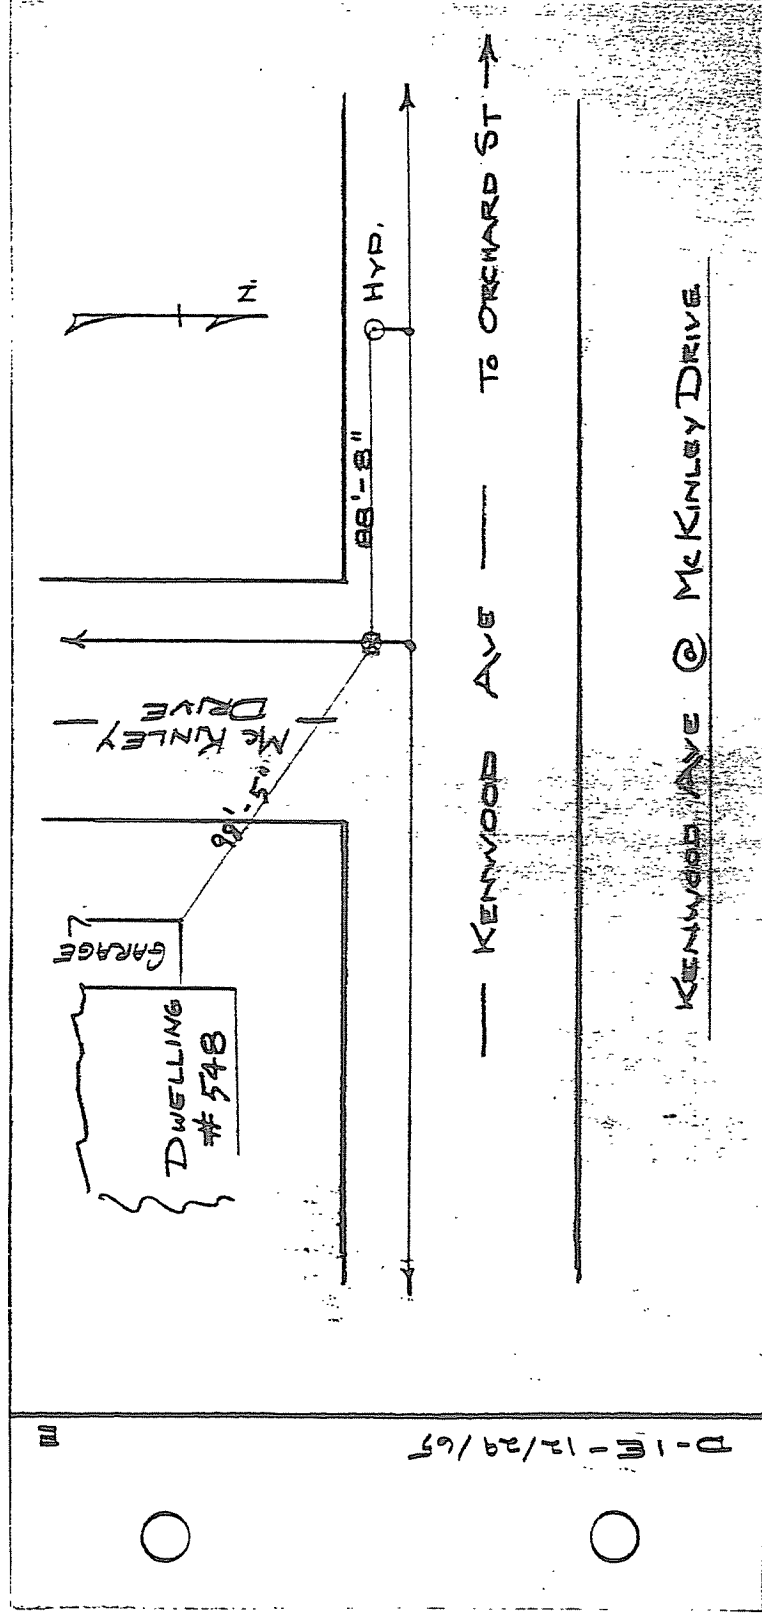


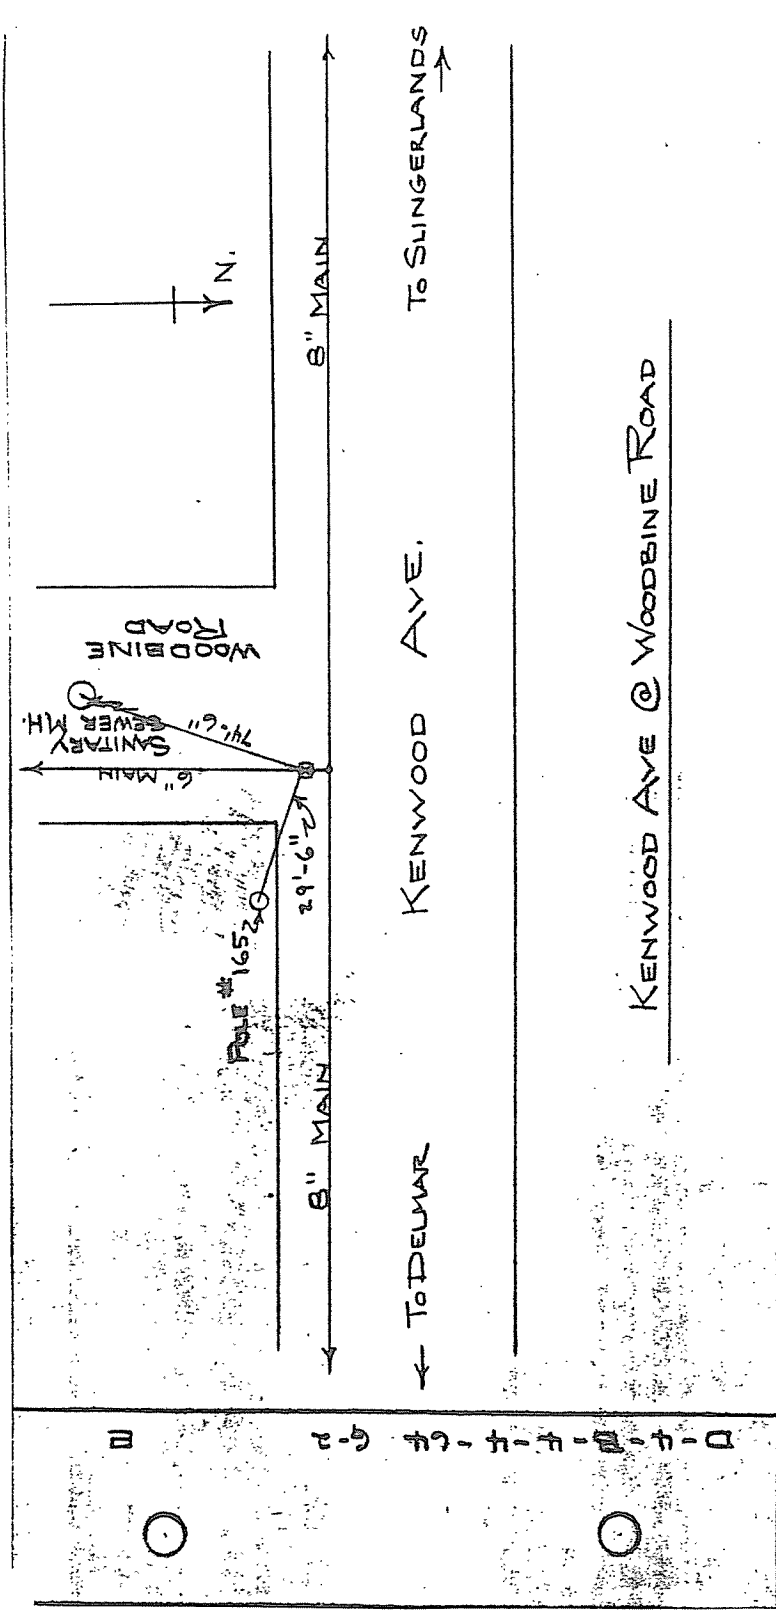

KENWOOD AVENUE

WATER MAIN