


N.

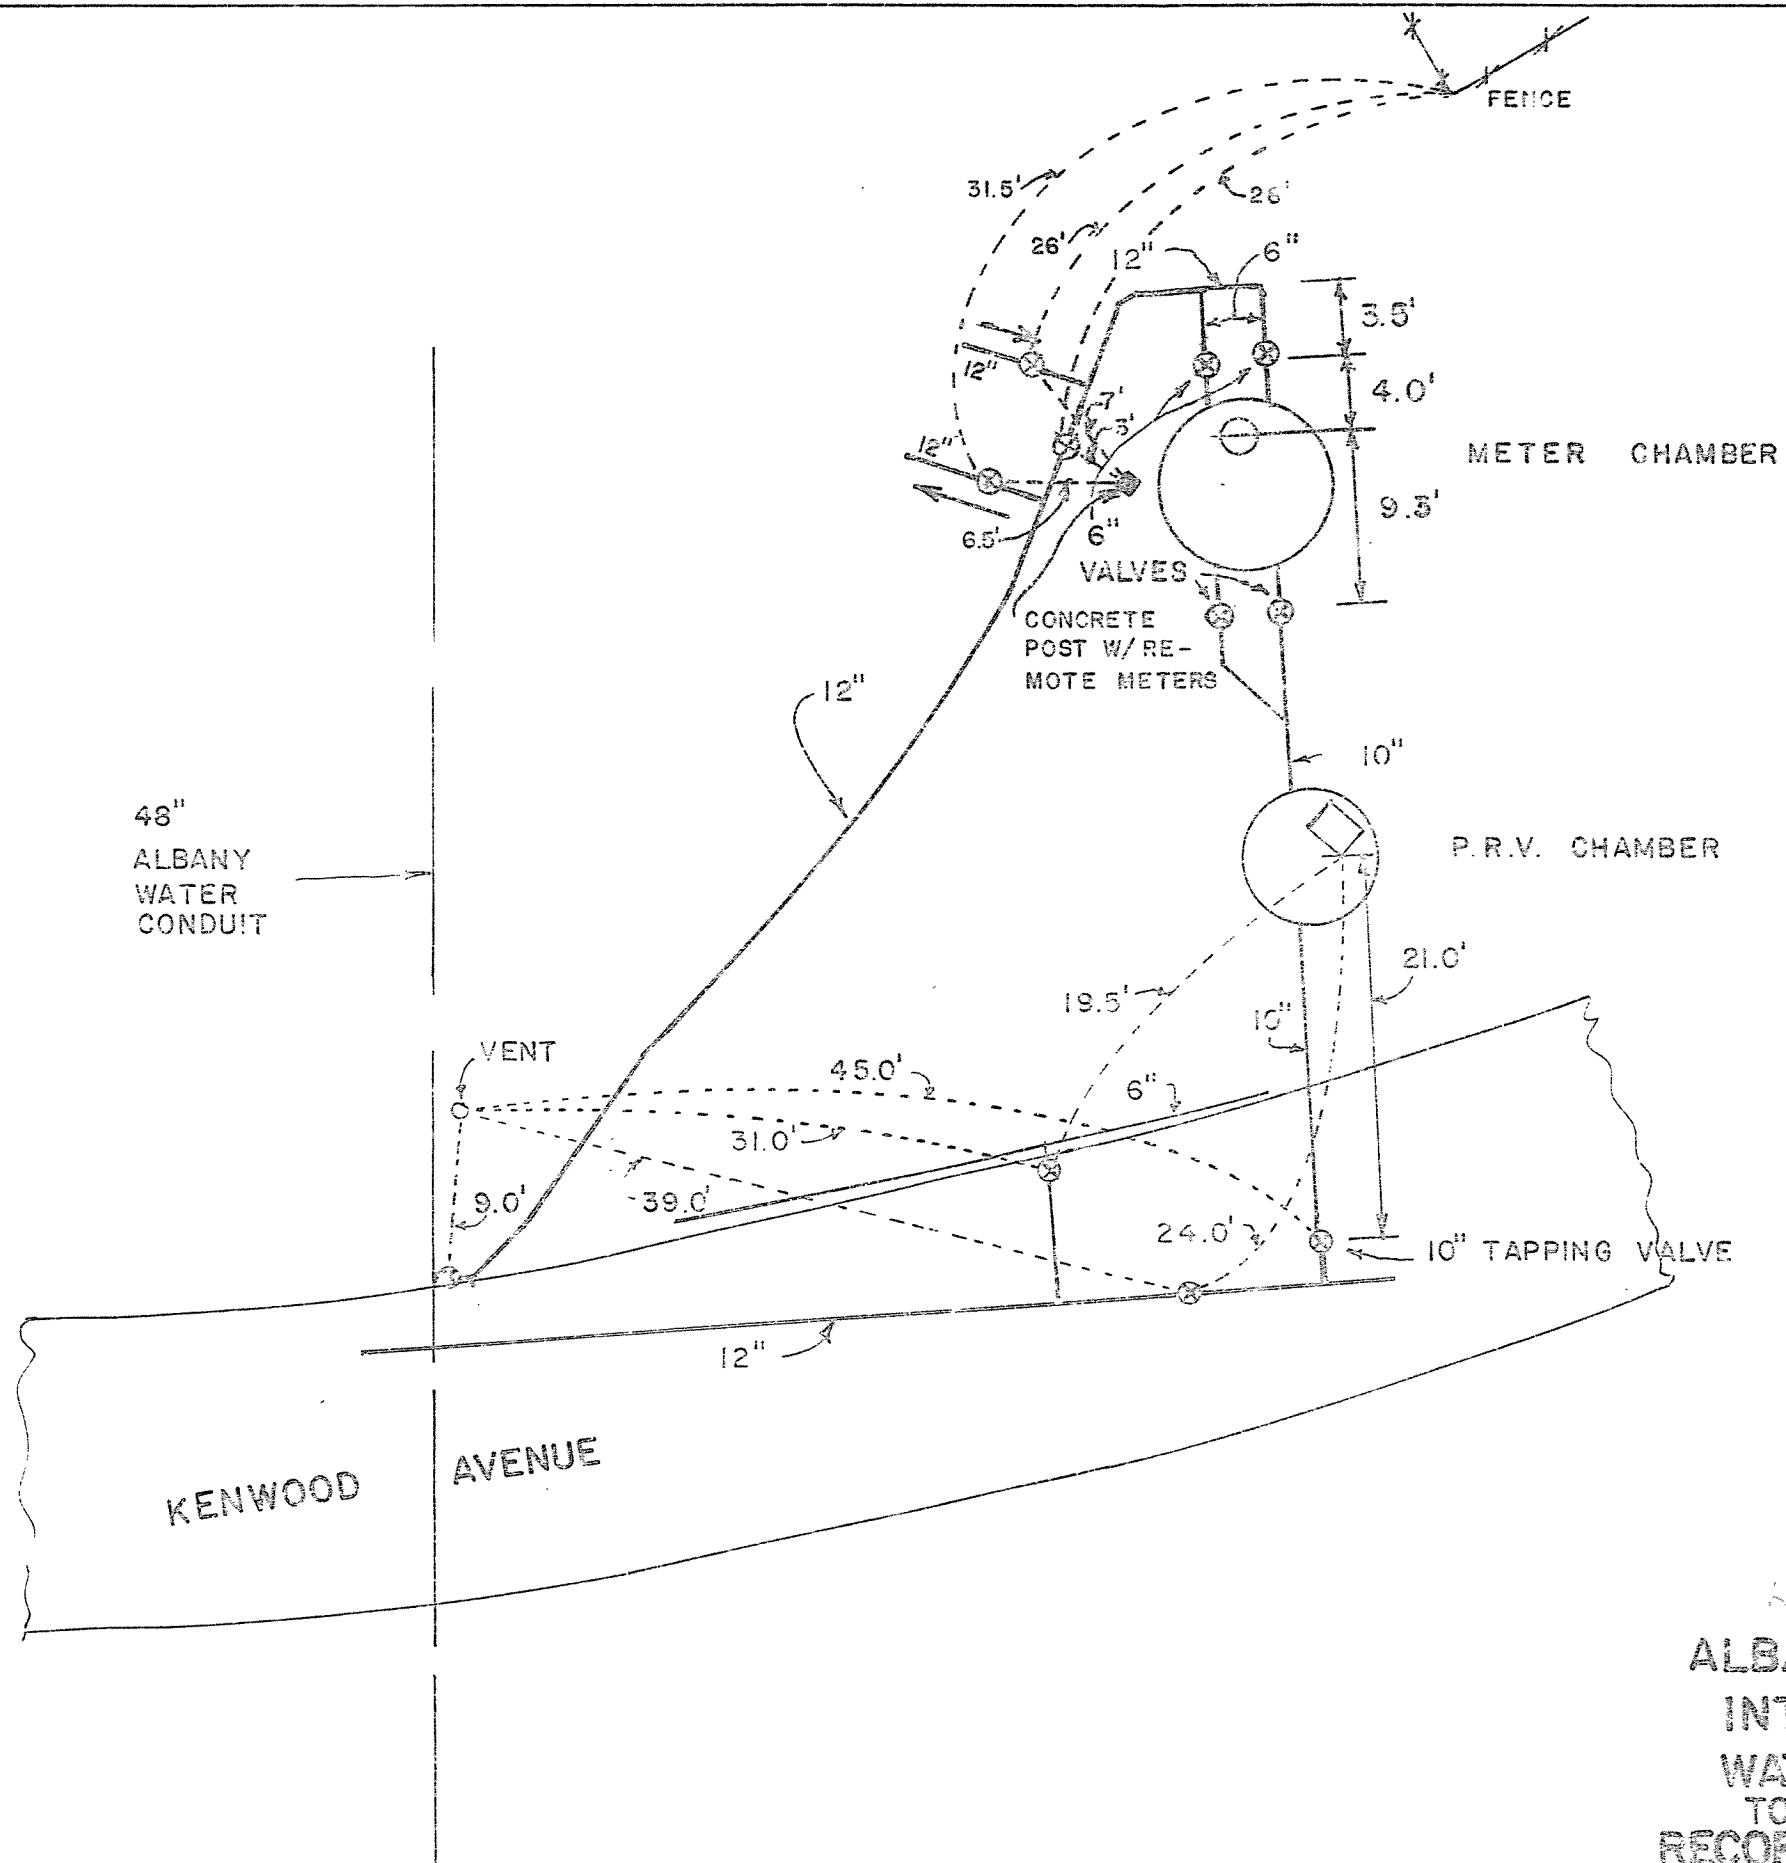

ALBANY-BETHLEHEM
INTERCONNECTION
WATER DISTRICT No. 1
TOWN OF BETHLEHEM
RECORD OF INSTALLATION
SCALE: 1" = 10' NOV. 1978
J. KENNETH FRASER & ASSOCIATES, P.C.
CONSULTING ENGINEERS RENSSELAER, N.Y.

REVISED 2-17-81