



**KENWOOD AVENUE**  
WATER DISTRICT NO. I  
TOWN OF BETHLEHEM  
**RECORD OF INSTALLATION**  
TOWN OF BETHLEHEM ENGINEERING  
DEPARTMENT  
SCALE: 1" = 50' DECEMBER, 1982  
DRAWN BY: PDH

N

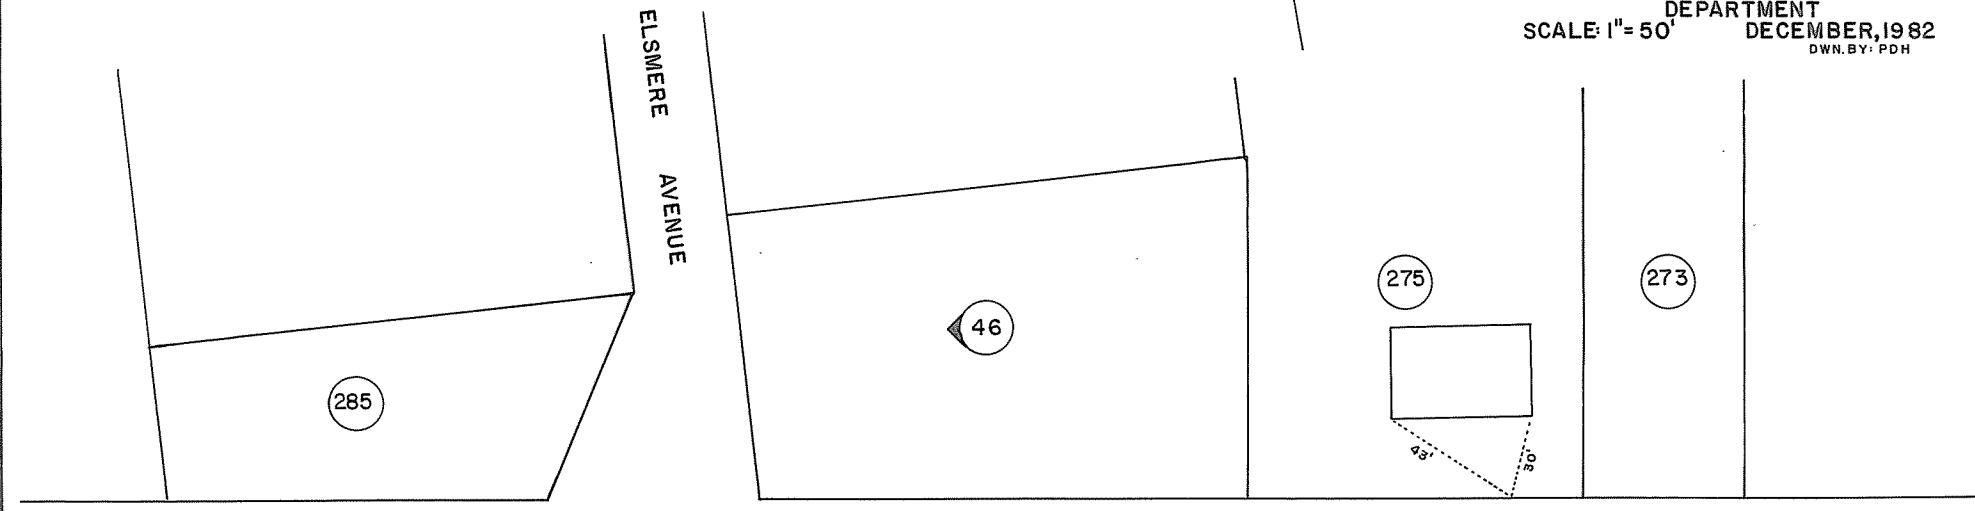

**KENWOOD**

**AVENUE**

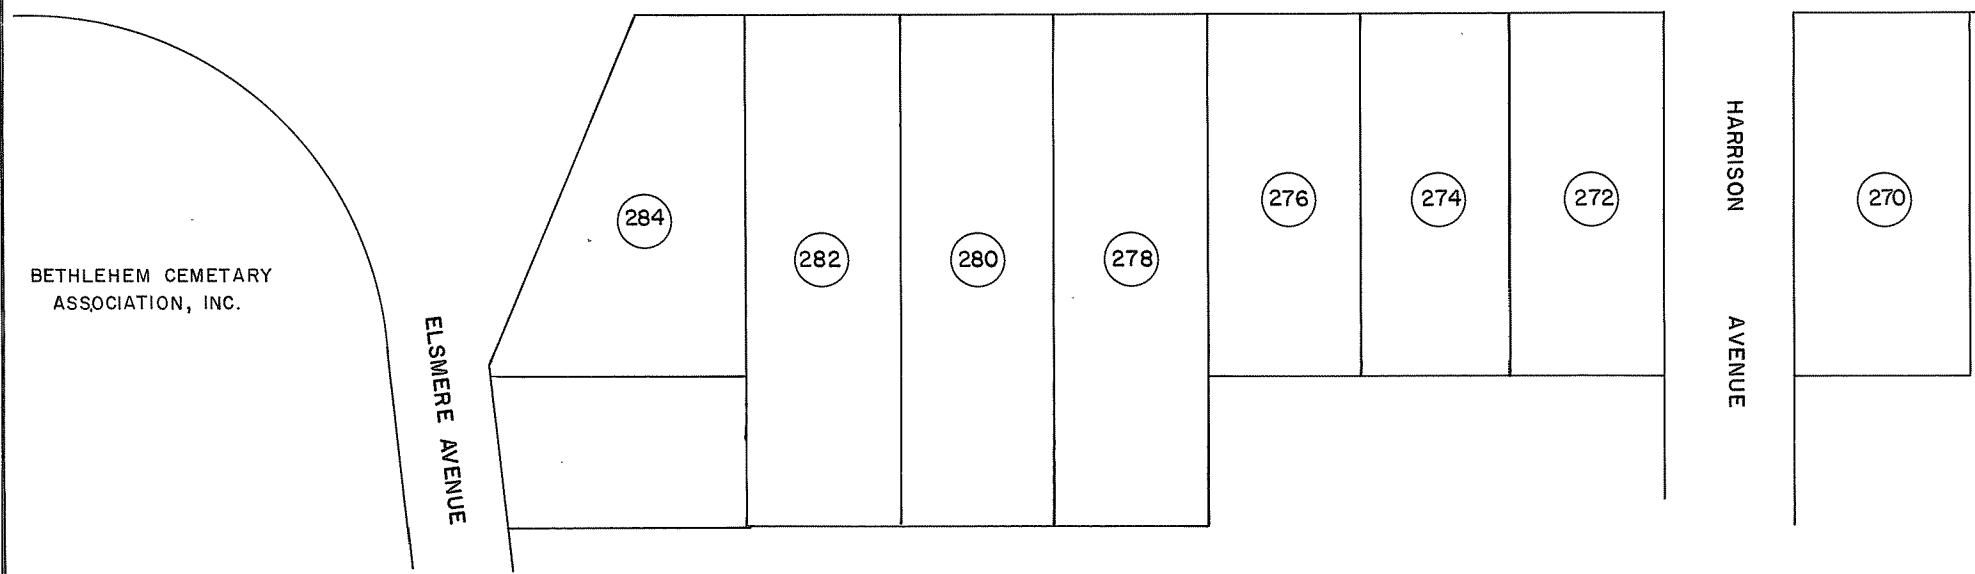

BETHLEHEM CEMETARY  
ASSOCIATION, INC.

ELSMERE AVENUE