

KENWOOD AVENUE
WATER DISTRICT NO. 1
TOWN OF BETHLEHEM
RECORD OF INSTALLATION
TOWN OF BETHLEHEM ENGINEERING
DEPARTMENT
SCALE: 1" = 50' DECEMBER, 1982
DWN. BY: PDH



AVENUE
DELSMERE

315

313

311

323

319

317

36

325
327

OAKWOOD

PLACE

333



331

329

KENWOOD

AVENUE

BETHLEHEM CENTRAL SCHOOL
DISTRICT NO. 6

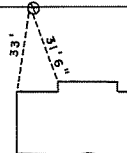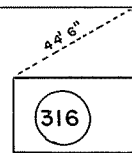

314

312

310

TOWN OF BETHLEHEM
WATER DISTRICT NO. 1