

KENWOOD AVENUE

WATER DISTRICT NO. I

TOWN OF BETHLEHEM

RECORD OF INSTALLATION


TOWN OF BETHLEHEM ENGINEERING

DEPARTMENT

SCALE: 1"=50' JANUARY, 1983

DWN. BY: PDH

N

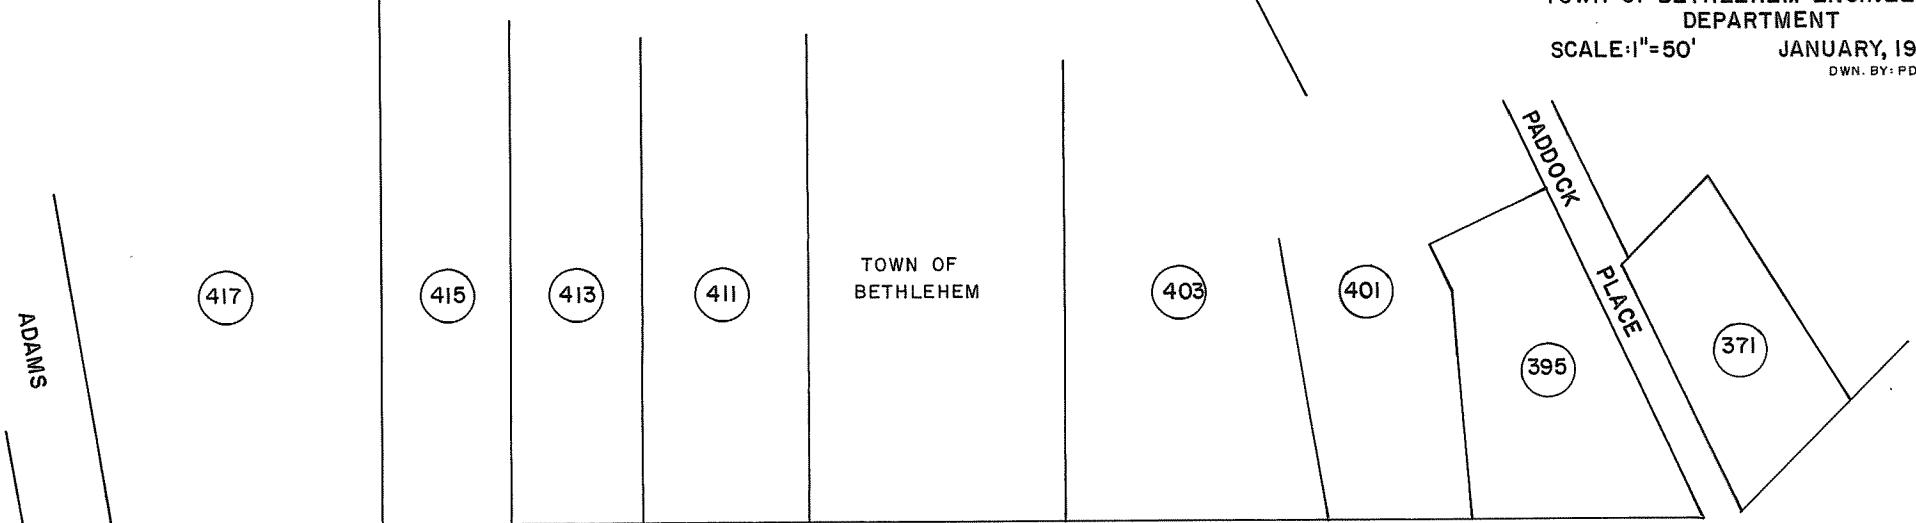

KENWOOD

AVENUE

STREET

416

414

412

410

408

406

DELAWARE

AVENUE

