


KENWOOD AVENUE
WATER DISTRICT NO. 1
TOWN OF BETHLEHEM
RECORD OF INSTALLATION
TOWN OF BETHLEHEM ENGINEERING
DEPARTMENT
SCALE: 1"=50' JANUARY, 1983
DWN. BY: PDH

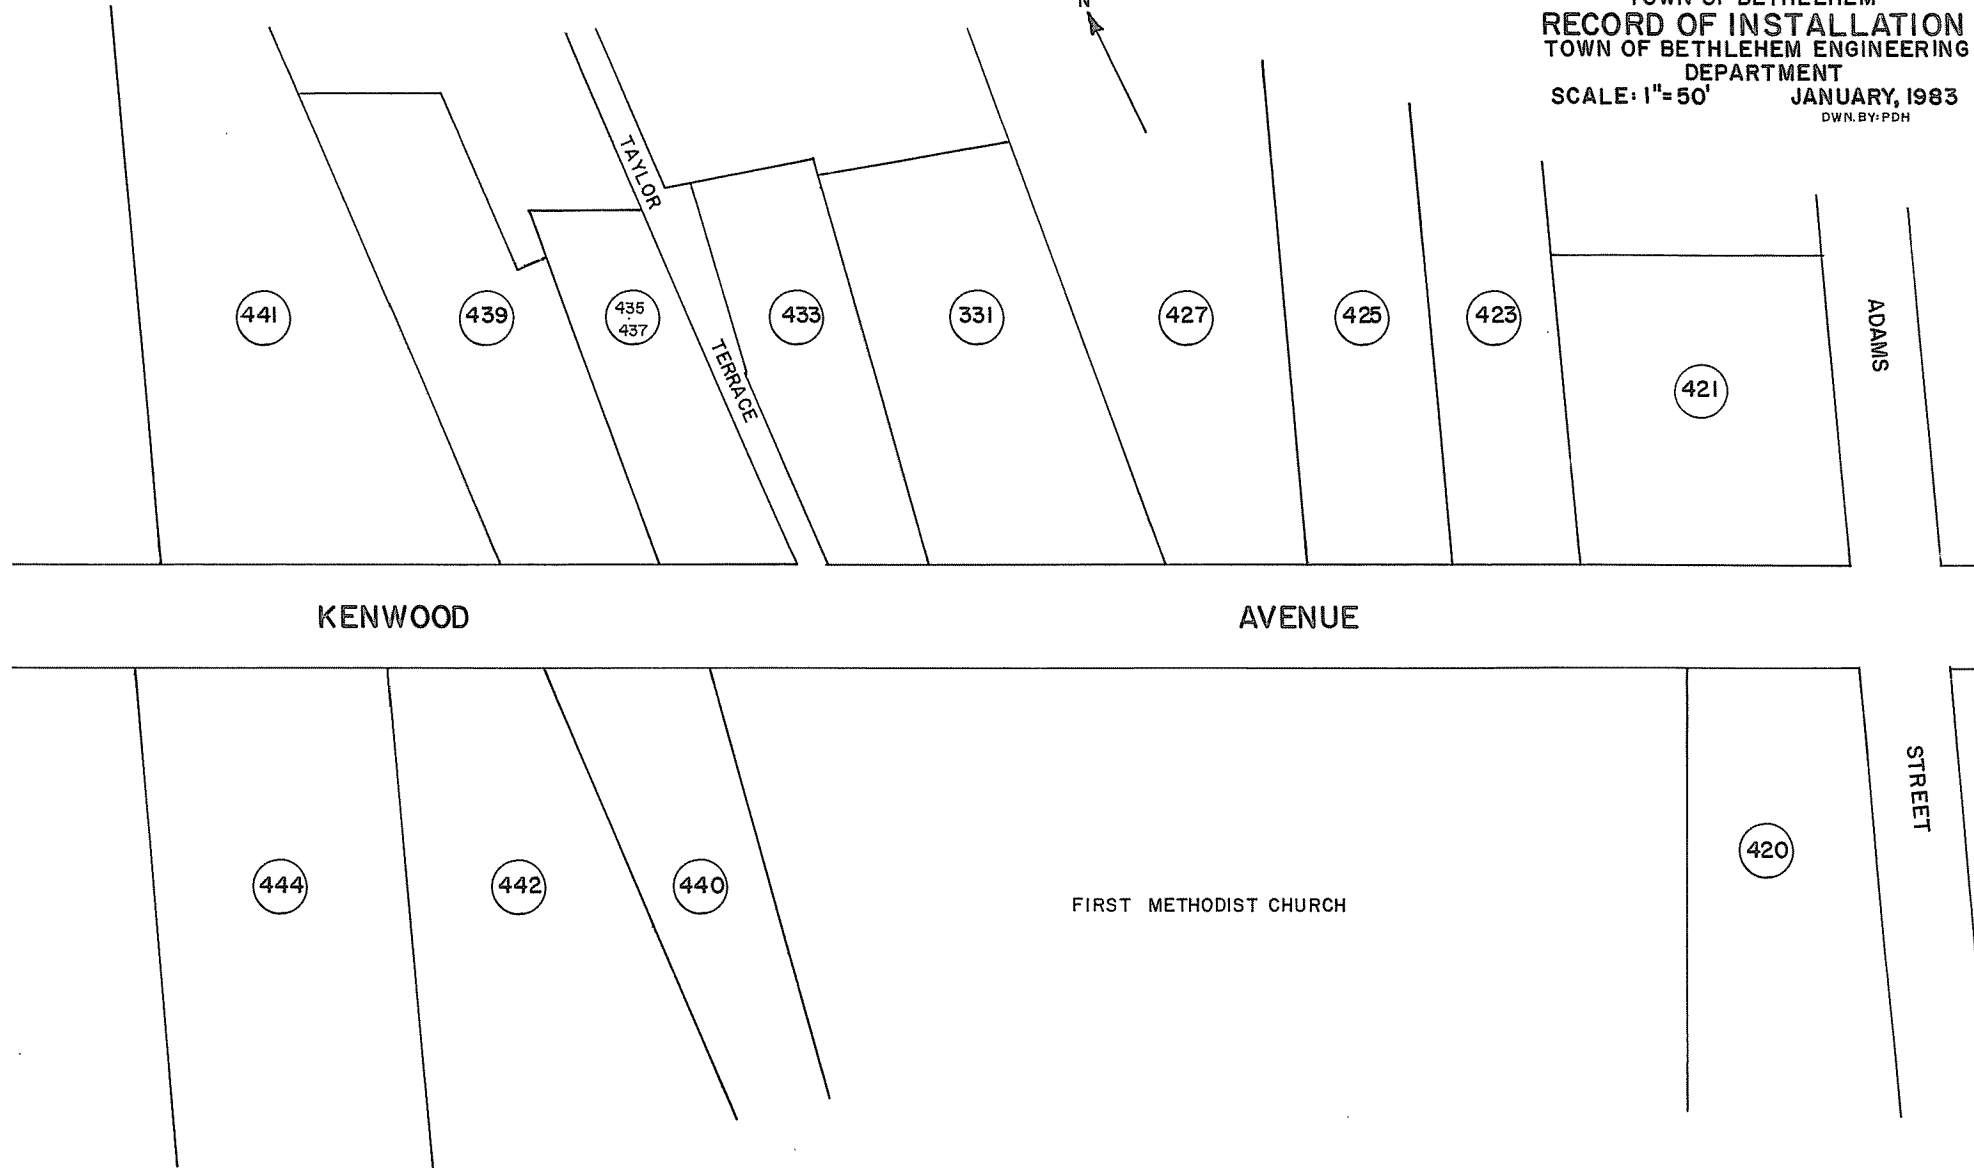

KENWOOD

AVENUE

ADAMS

STREET

FIRST METHODIST CHURCH