



KENWOOD AVENUE
WATER DISTRICT NO.1
TOWN OF BETHLEHEM
RECORD OF INSTALLATION
TOWN OF BETHLEHEM ENGINEERING
DEPARTMENT
SCALE: 1" = 50' JANUARY, 1983
DWN. BY: PDH

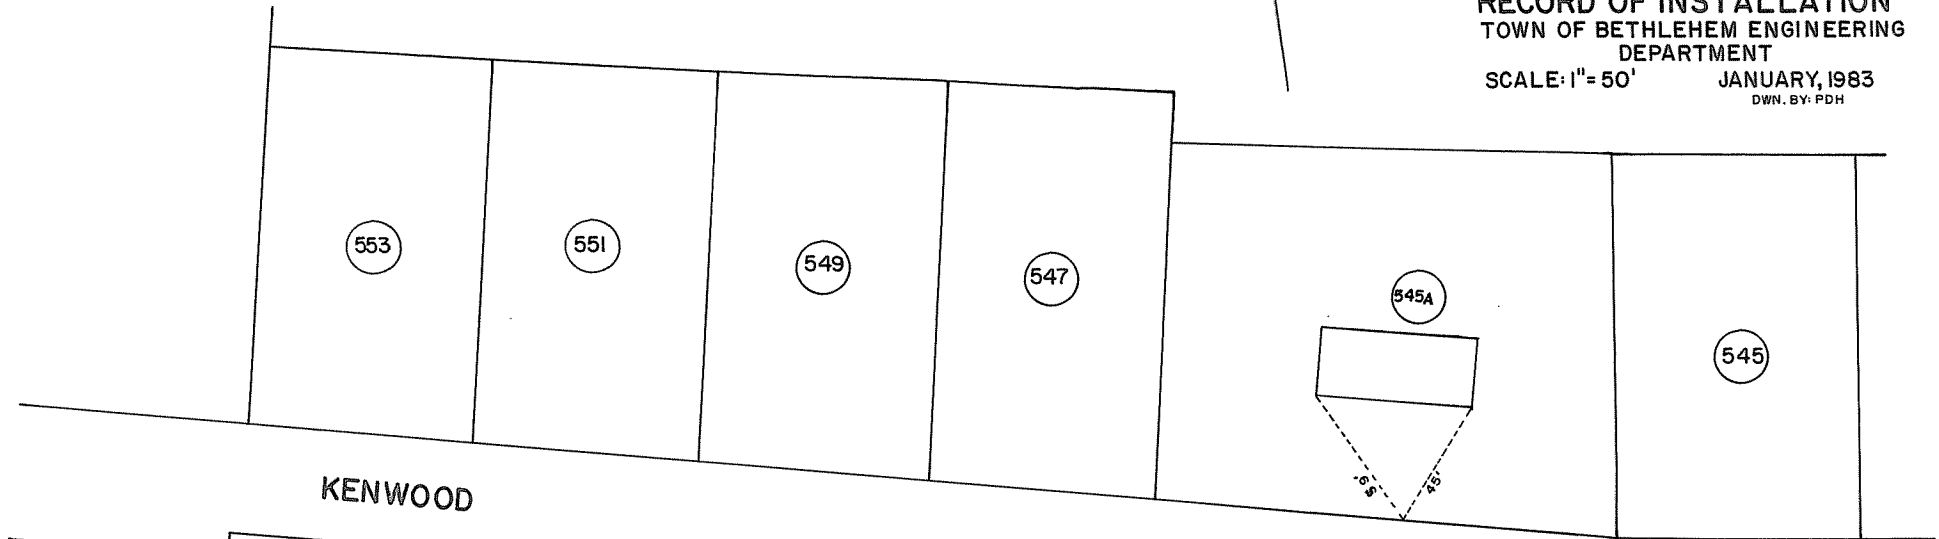

KENWOOD

AVENUE

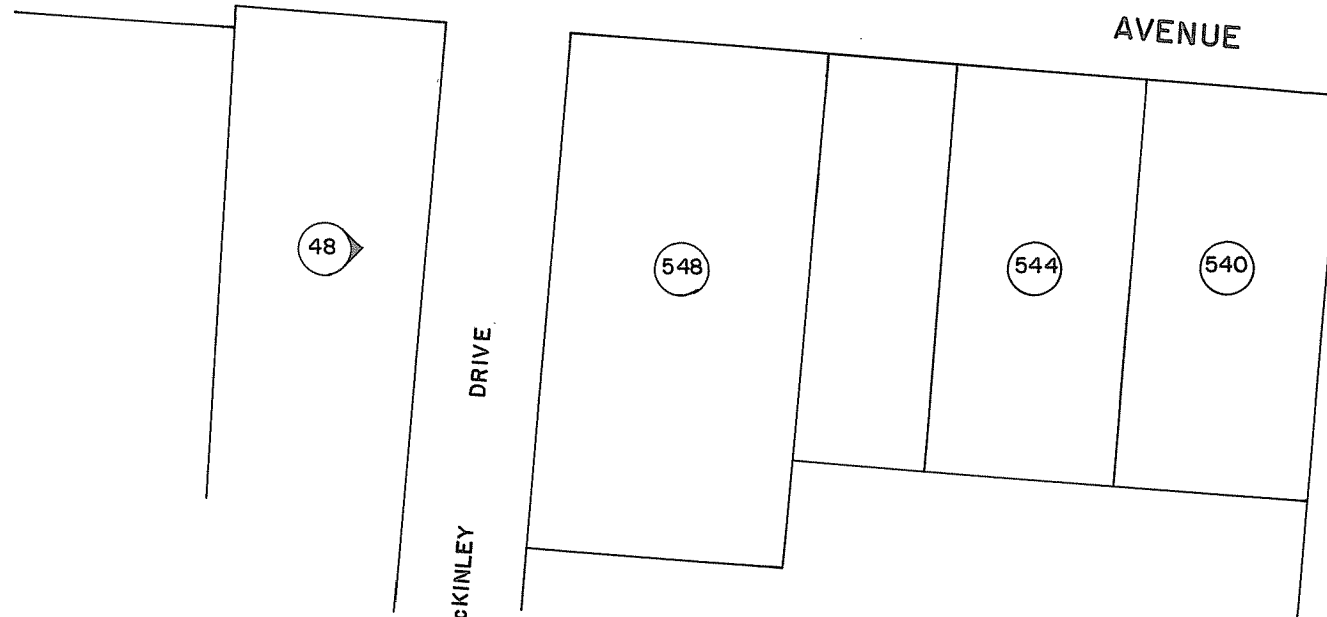

McKINLEY
DRIVE

MEADOWLAND
STREET

