
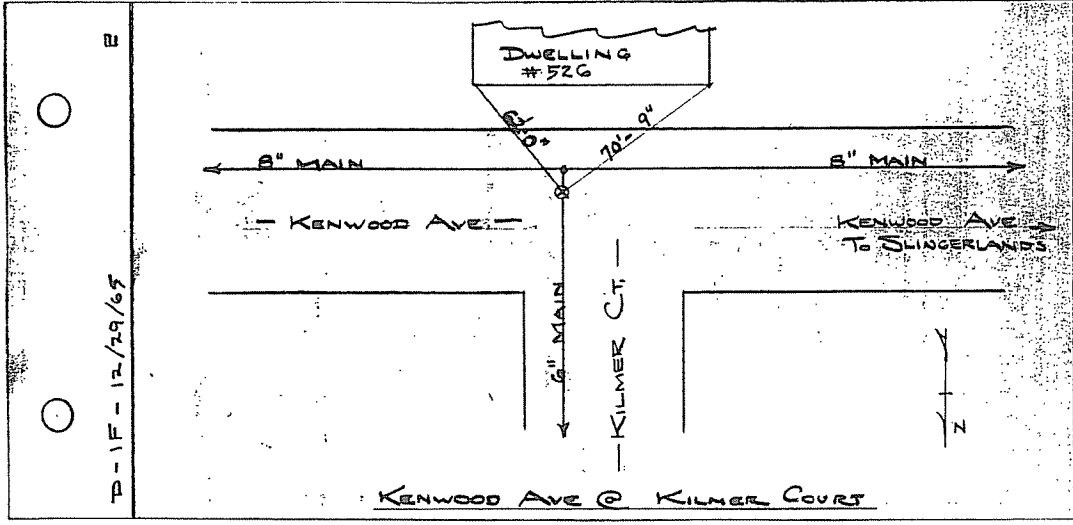


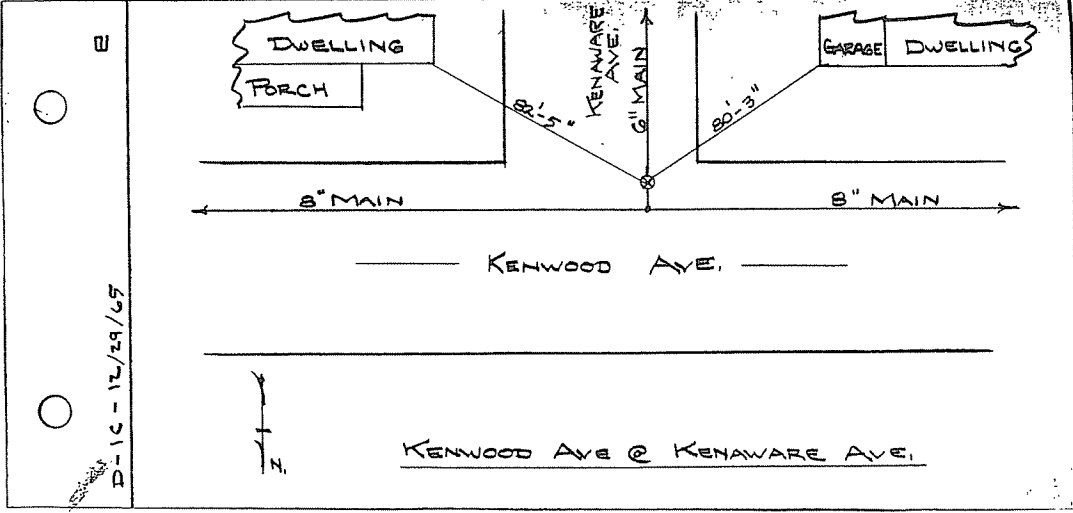

KENWOOD AVENUE
WATER MAIN