


KENWOOD AVENUE  
WATER DISTRICT NO.1  
TOWN OF BETHLEHEM  
**RECORD OF INSTALLATION**  
TOWN OF BETHLEHEM ENGINEERING  
DEPARTMENT  
SCALE: 1" = 50' JANUARY, 1983  
DWN. BY: PDH

N

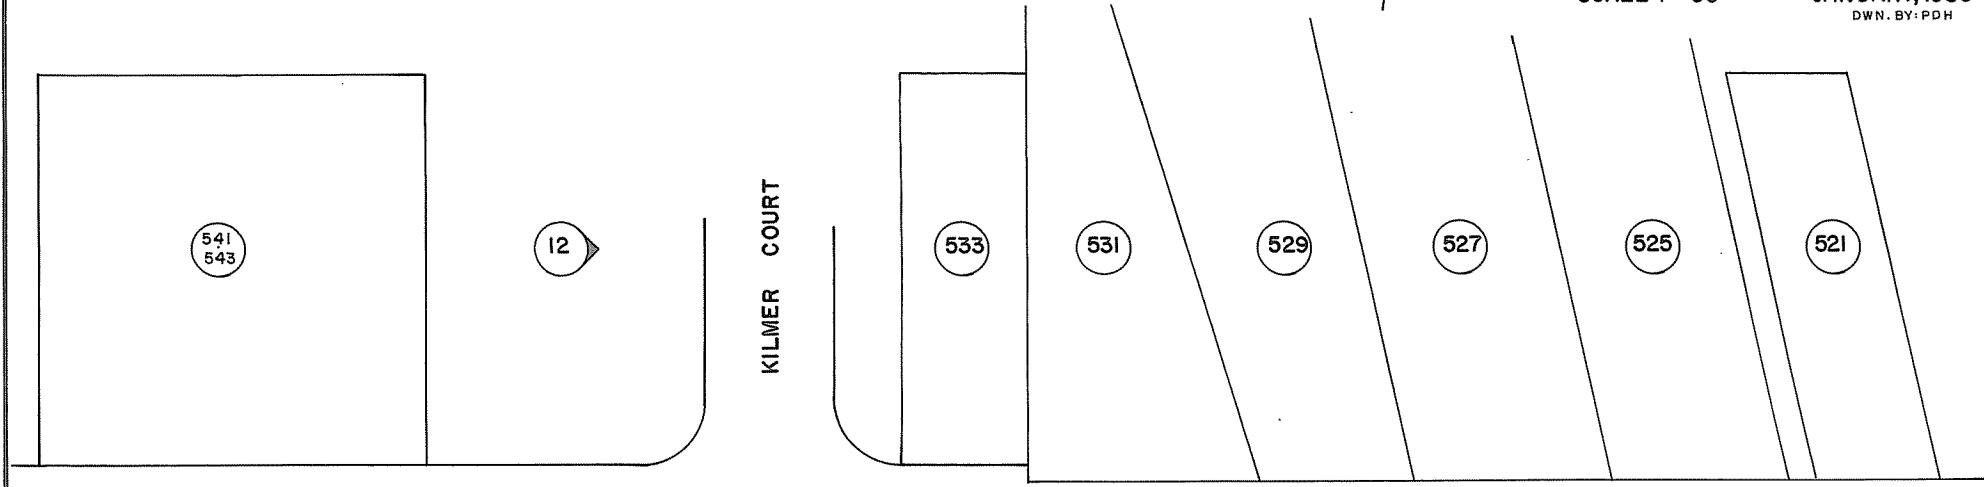

KENWOOD

AVENUE

