


KENWOOD AVENUE
WATER DISTRICT NO.1
TOWN OF BETHLEHEM

RECORD OF INSTALLATION
TOWN OF BETHLEHEM ENGINEERING
DEPARTMENT
SCALE: 1" = 50' JANUARY, 1983

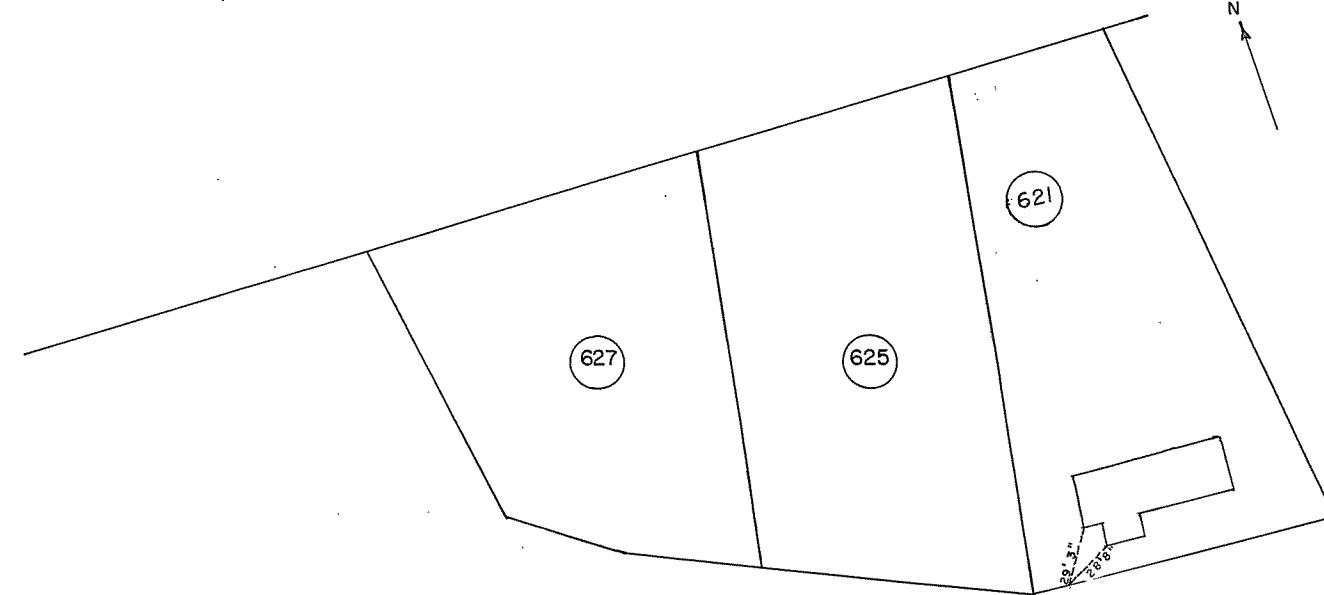

KENWOOD

AVENUE

CHERRY AVENUE

