


KENWOOD AVENUE  
WATER DISTRICT NO.1  
TOWN OF BETHLEHEM  
RECORD OF INSTALLATION  
TOWN OF BETHLEHEM ENGINEERING  
DEPARTMENT  
SCALE: 1"=50' JANUARY, 1983  
DWN. BY: PDH

N

ROCKEFELLER ROAD

I35

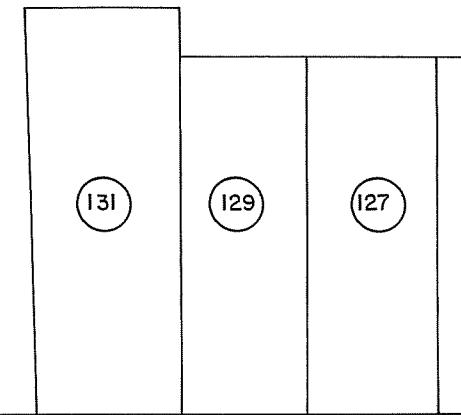


KENWOOD

AVENUE

BROOKVIEW

AVENUE

I34

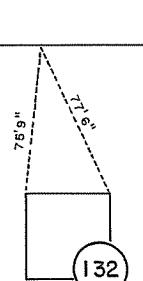

I30

O.M.H. 33'  
38'-6"  
C.B.  
N.M. #60

I30.1

I28

OAKWOOD ROAD