

KENWOOD AVENUE
WATER DISTRICT NO. 1
TOWN OF BETHLEHEM
RECORD OF INSTALLATION
TOWN OF BETHLEHEM ENGINEERING
DEPARTMENT
SCALE: 1"=50' JANUARY, 1983
DWN. BY: PDH

N

CITY OF ALBANY

WOODRIDGE ROAD

215

213

1

209

207

KENWOOD


AVENUE

DUMBARTON DRIVE

MONTROSE DRIVE

214

212

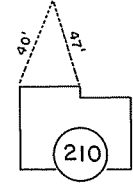

210

208

206

204

202

200