


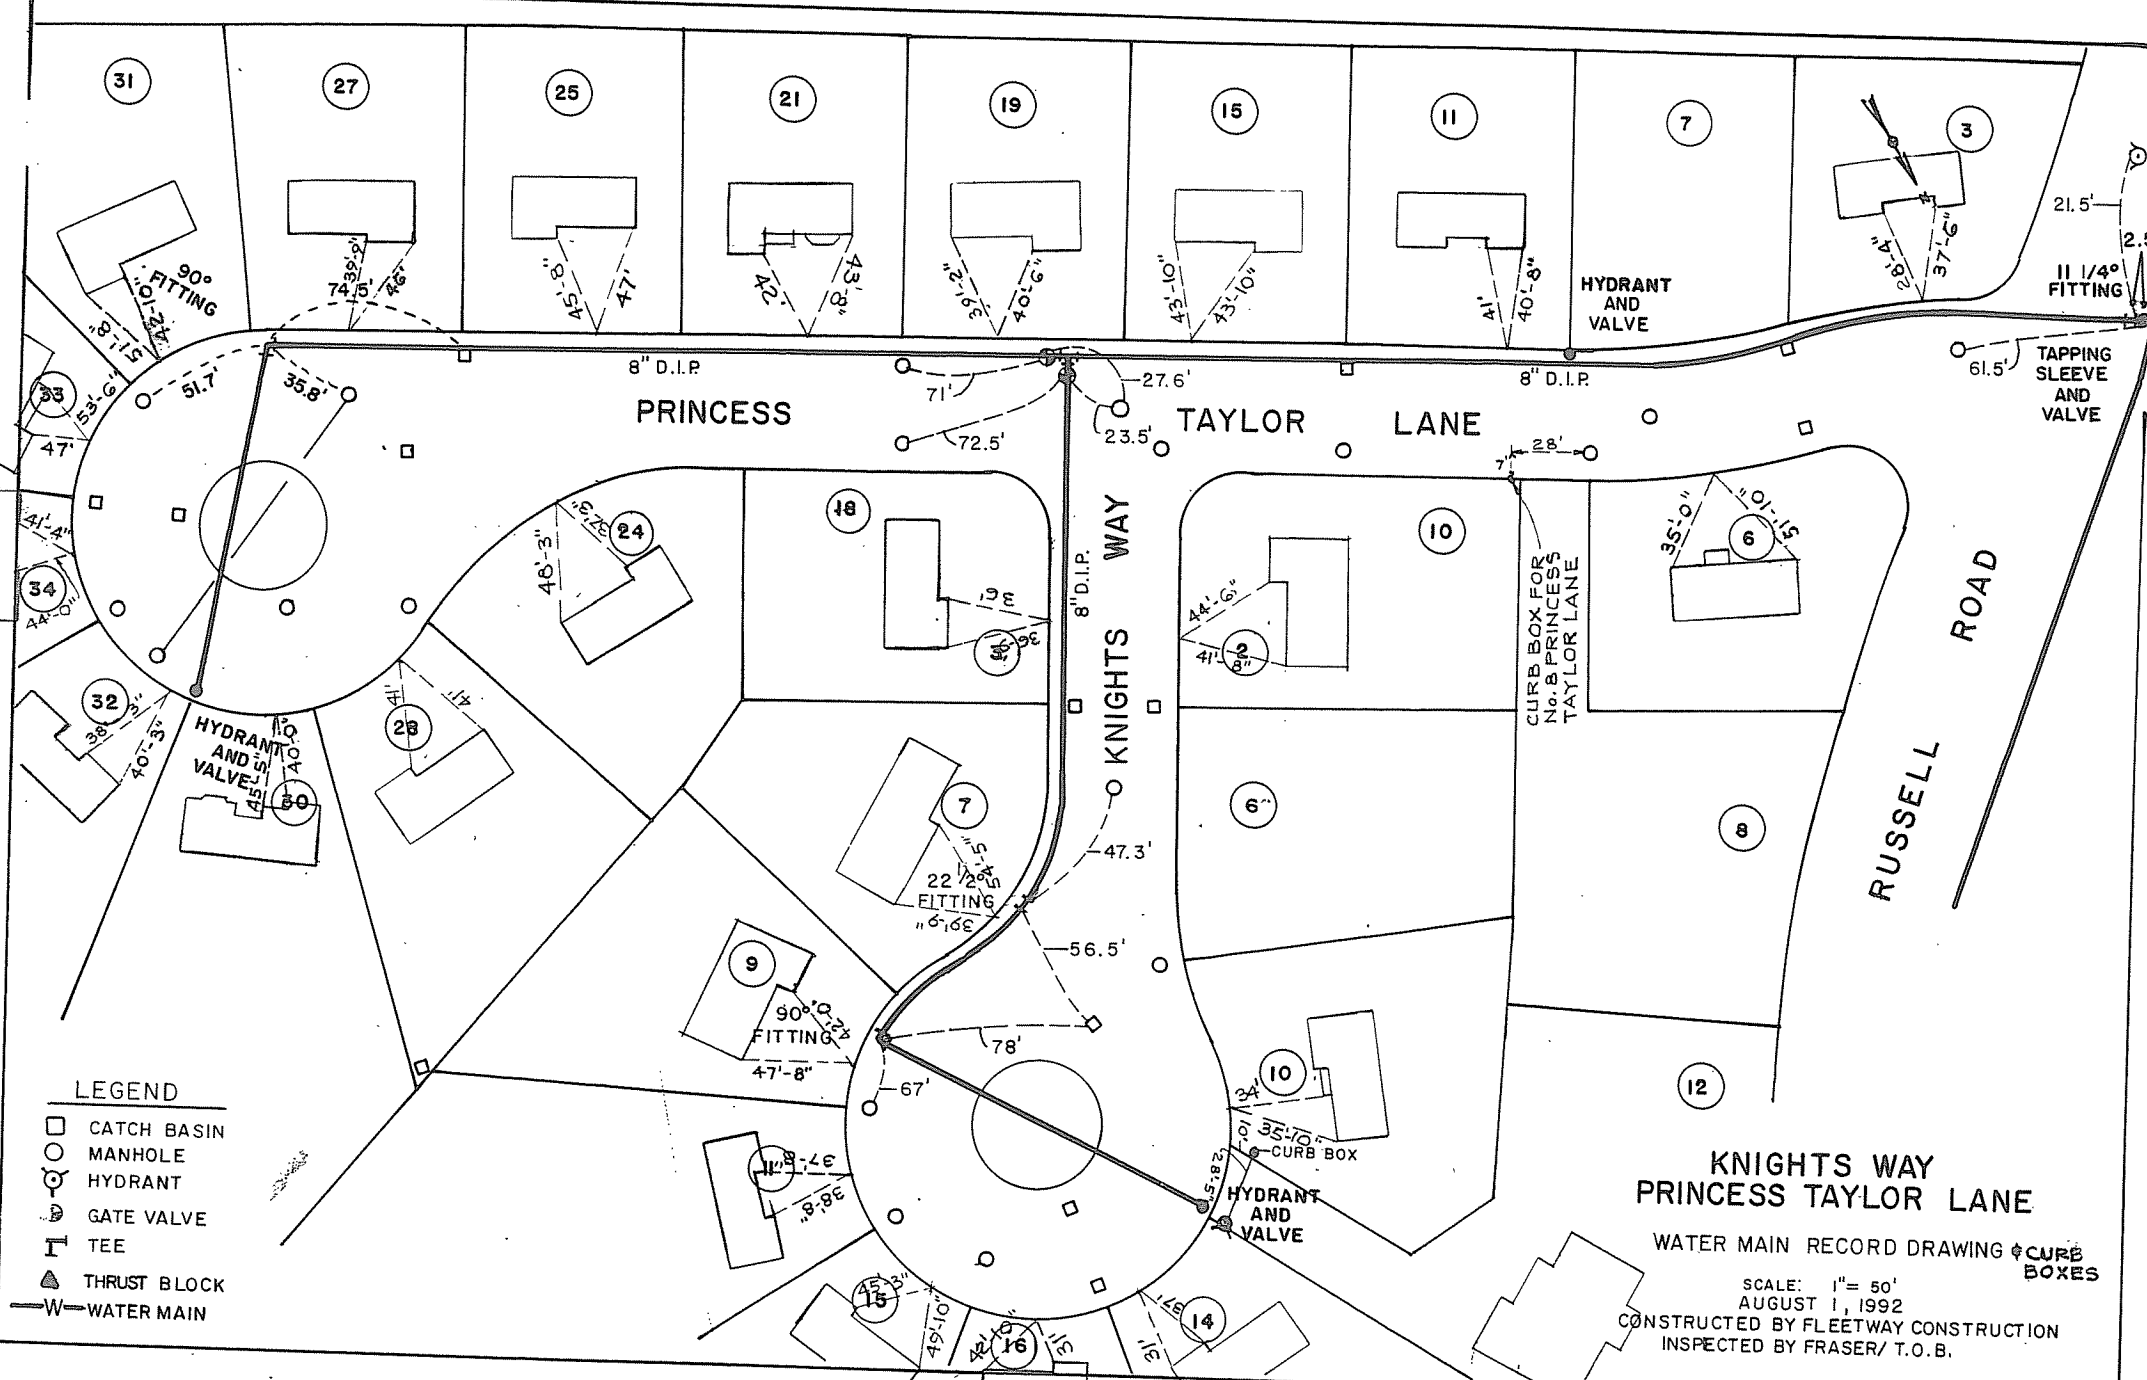

LEGEND

- CATCH BASIN
- MANHOLE
- ⊙ HYDRANT
- ⊕ GATE VALVE
- ⊥ TEE
- ▲ THRUST BLOCK
- W— WATER MAIN

KNIGHTS WAY
PRINCESS TAYLOR LANE

WATER MAIN RECORD DRAWING & CURB BOXES

SCALE: 1" = 50'
AUGUST 1, 1992
CONSTRUCTED BY FLEETWAY CONSTRUCTION
INSPECTED BY FRASER/ T.O.B.