


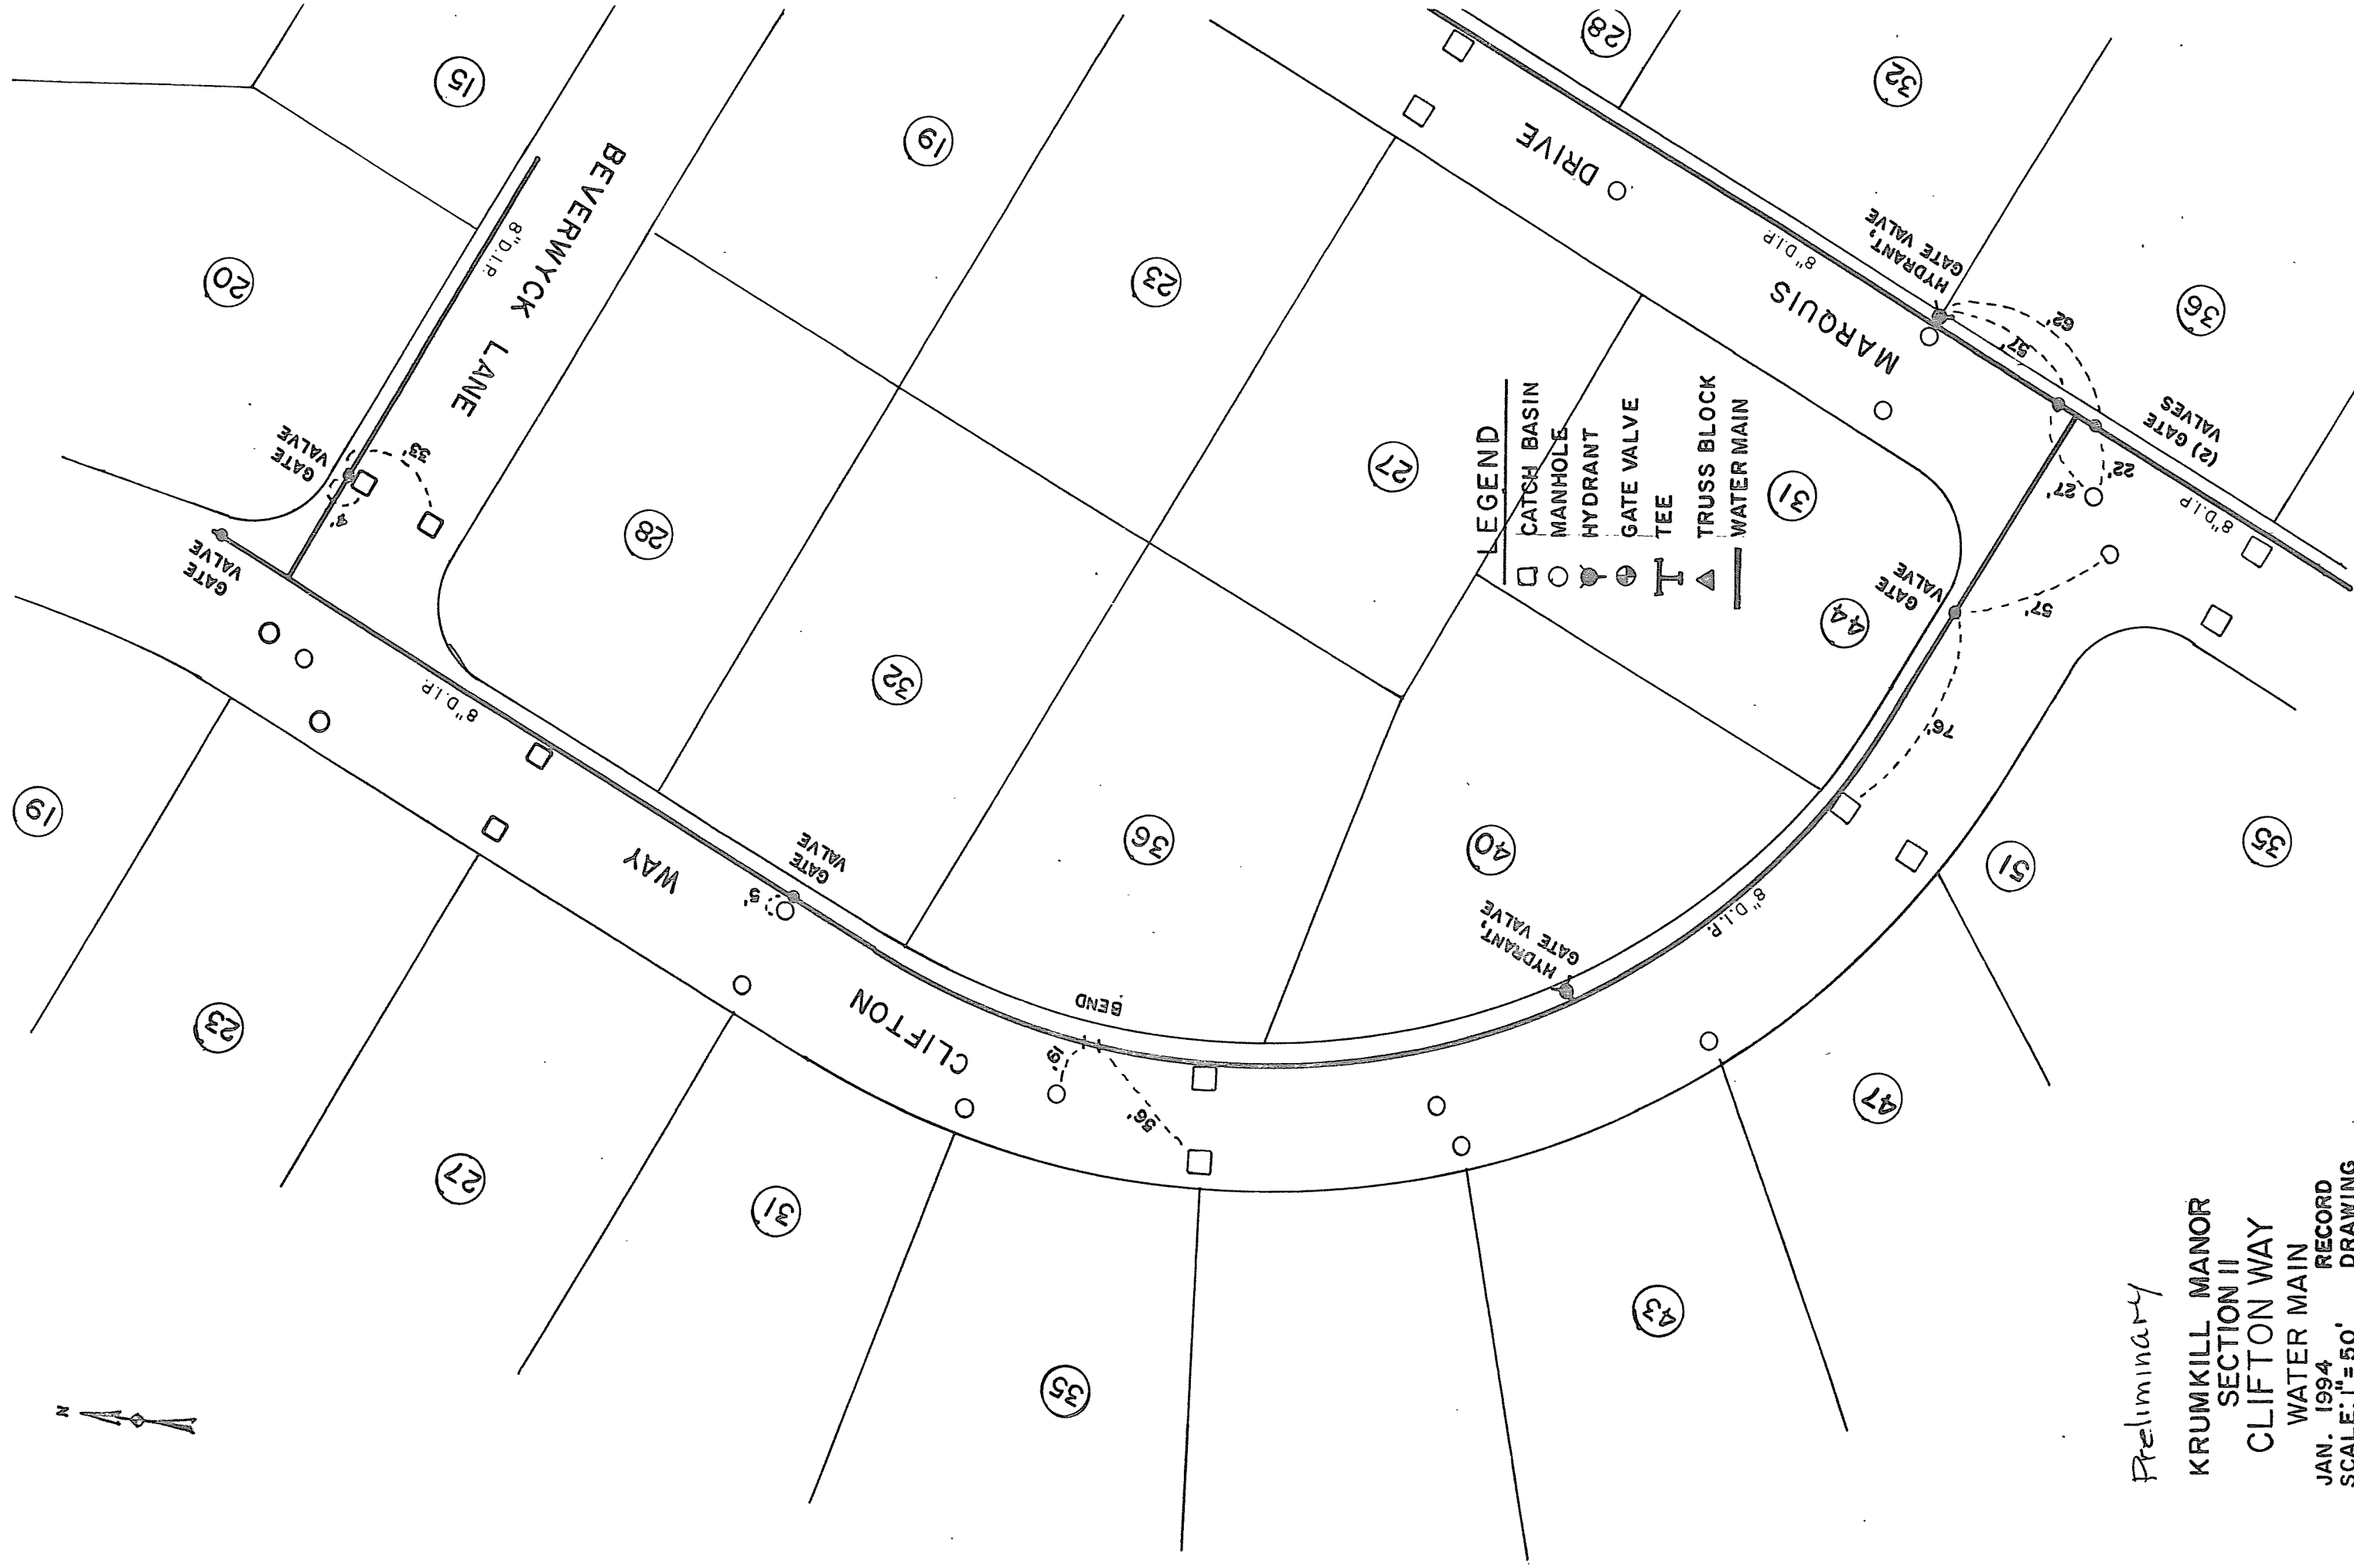

Preliminary

KRUMKILL MANOR

SECTION II

CLIFTON WAY

WATER MAIN

JAN. 1994 RECORD

SCALE: 1" = 50'

BY RICK CARVER EXCAVATION