


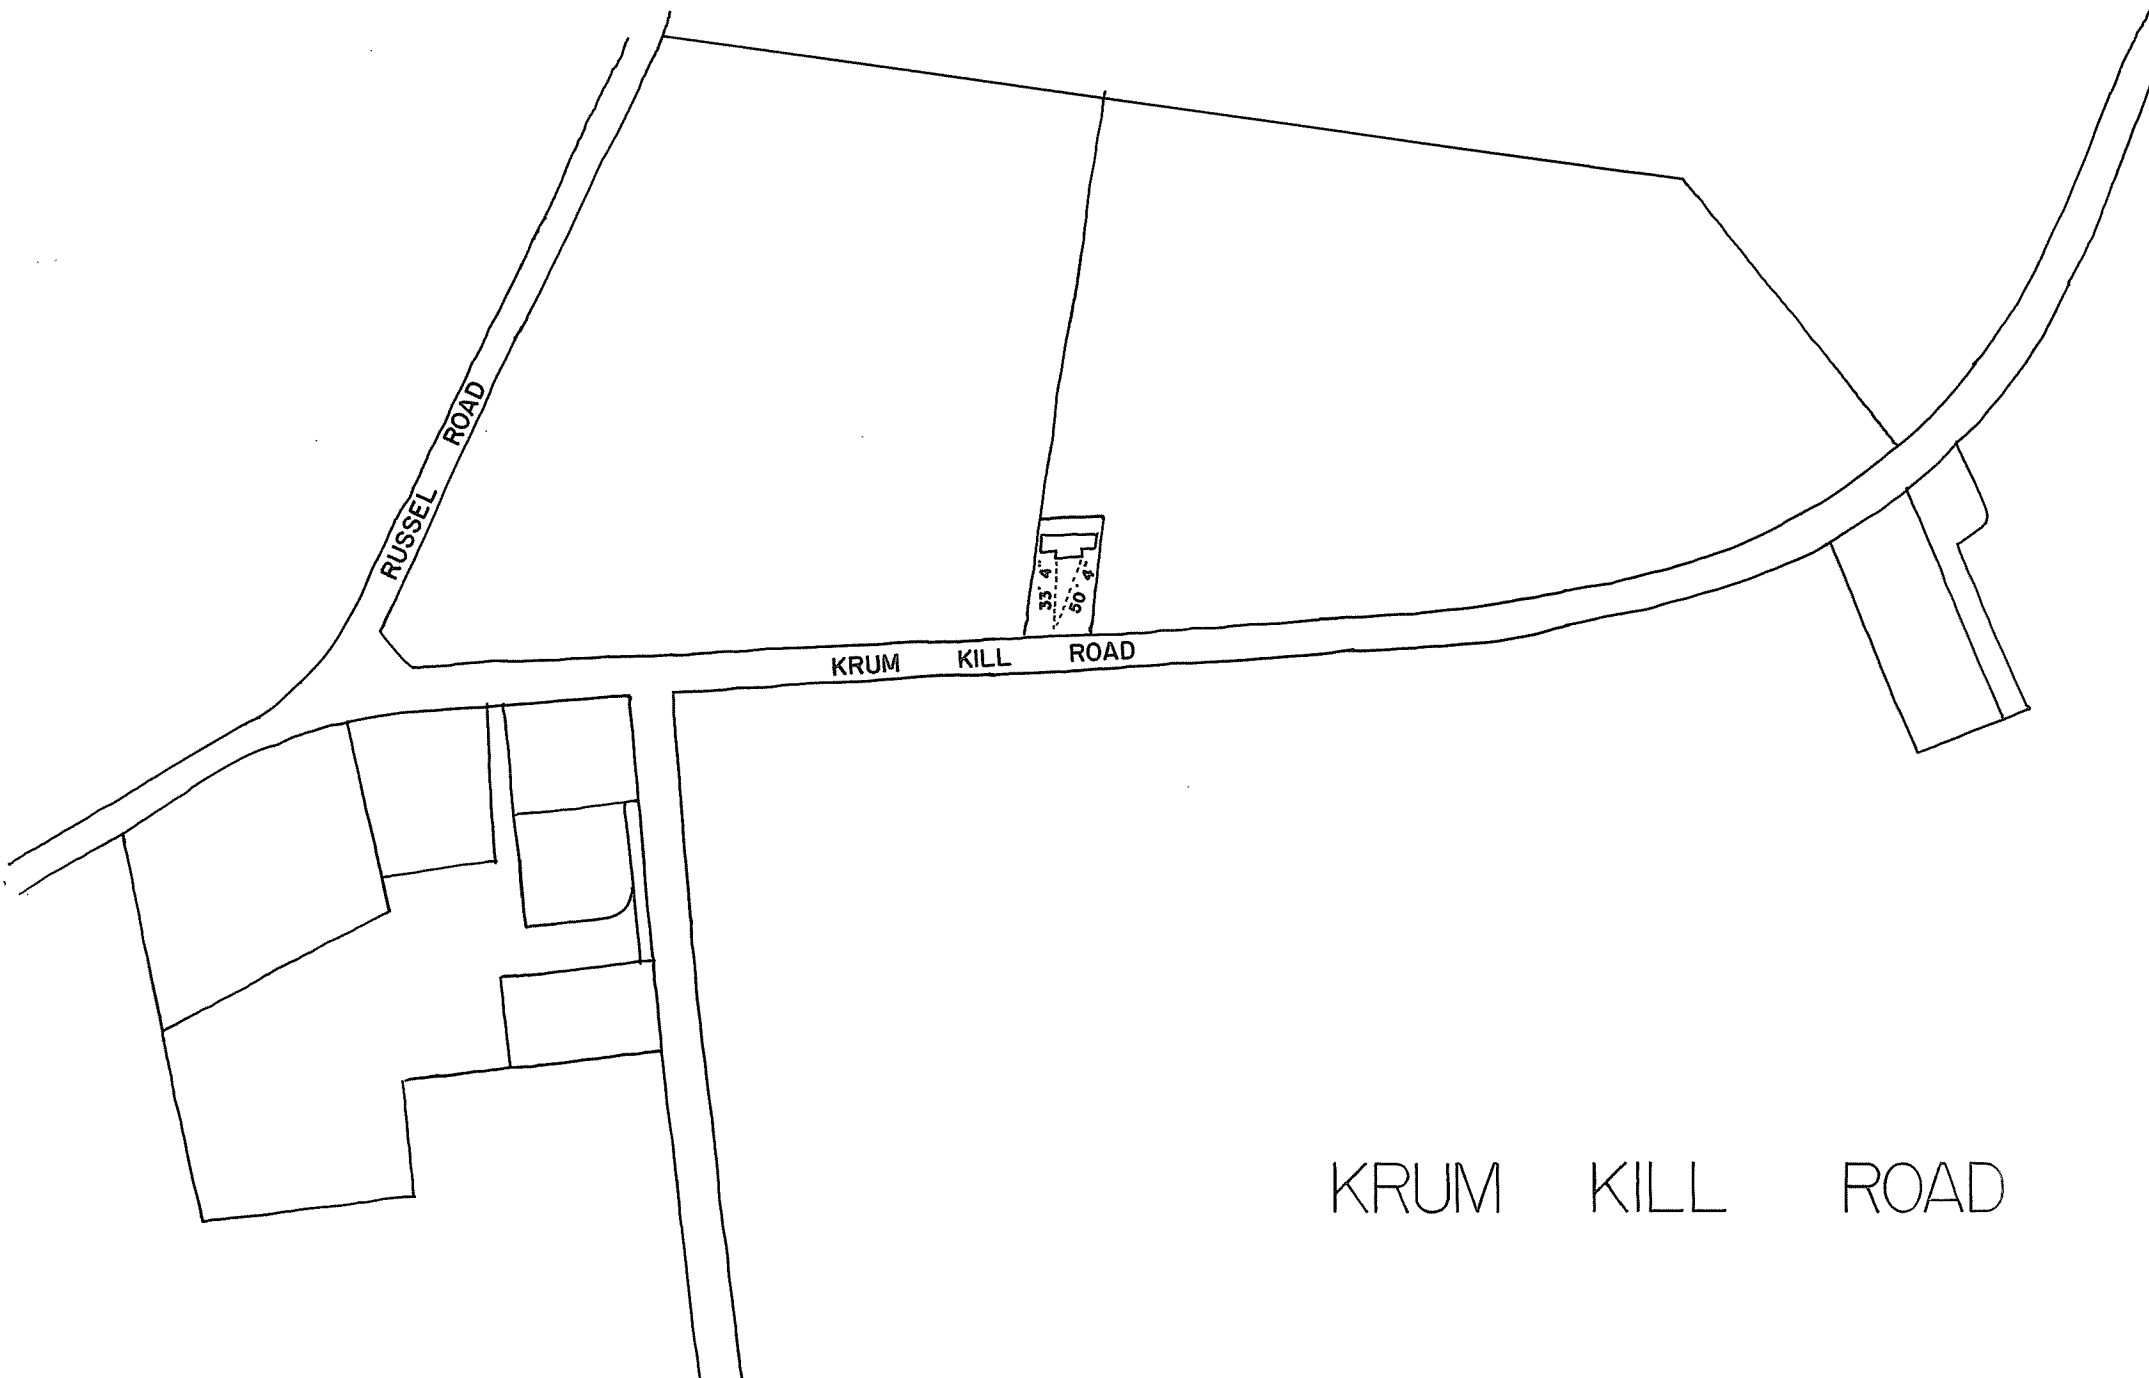

KRUM KILL ROAD