

LINCOLN AVENUE

WATER DISTRICT NO. 1

TOWN OF BETHLEHEM

RECORD OF INSTALLATION

TOWN OF BETHLEHEM ENGINEERING


DEPARTMENT

SCALE: 1"=50'

MARCH, 1982


DWN. BY: PDH

N

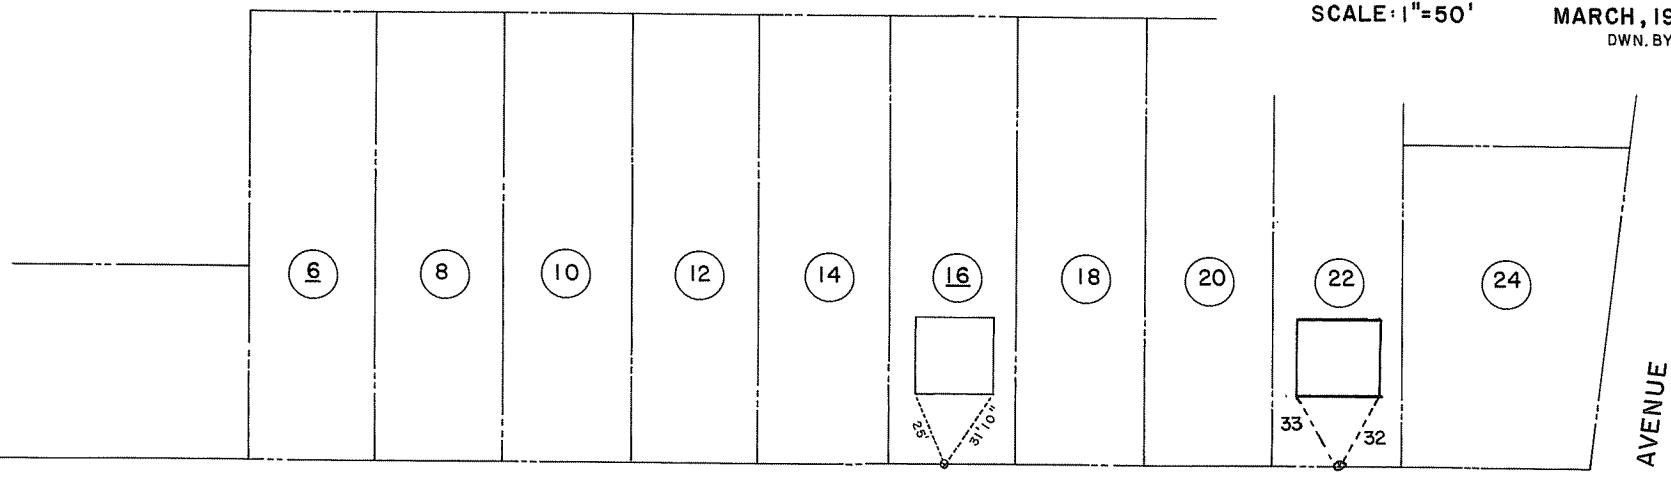

LINCOLN

AVENUE

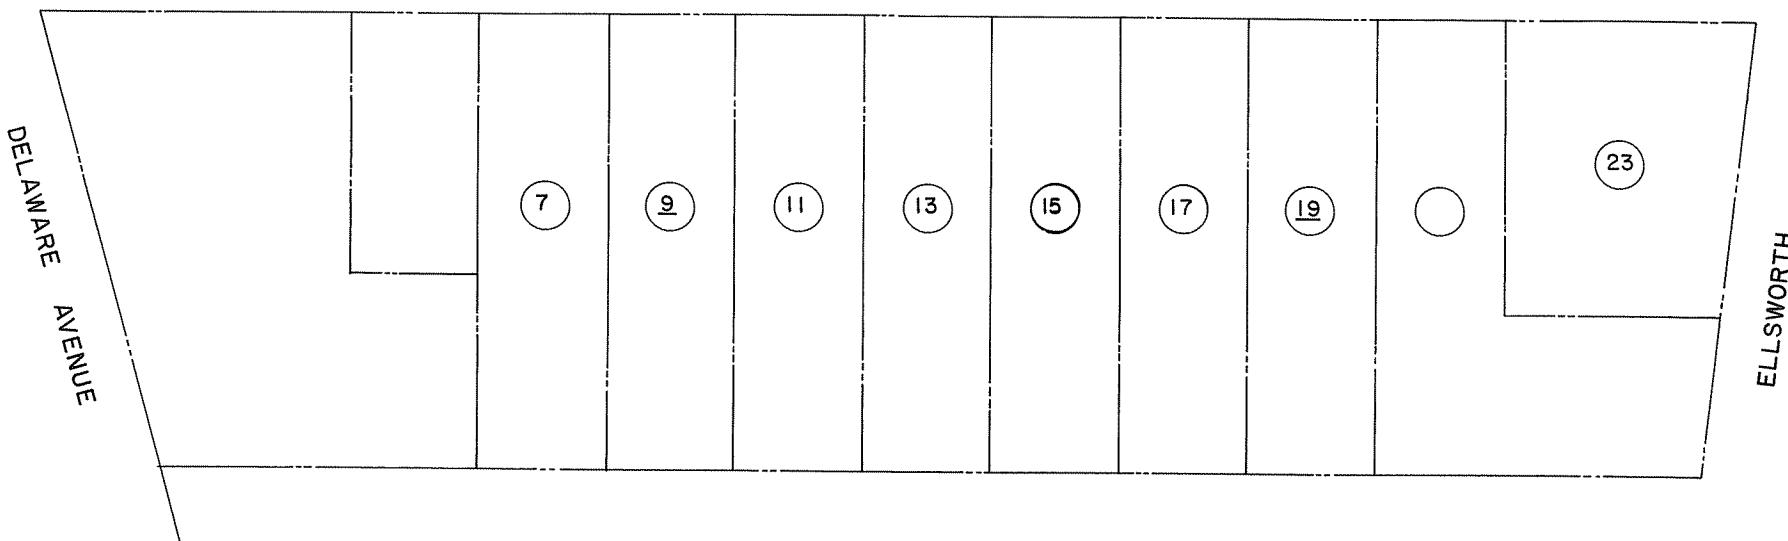

ELLSWORTH