


PT 11

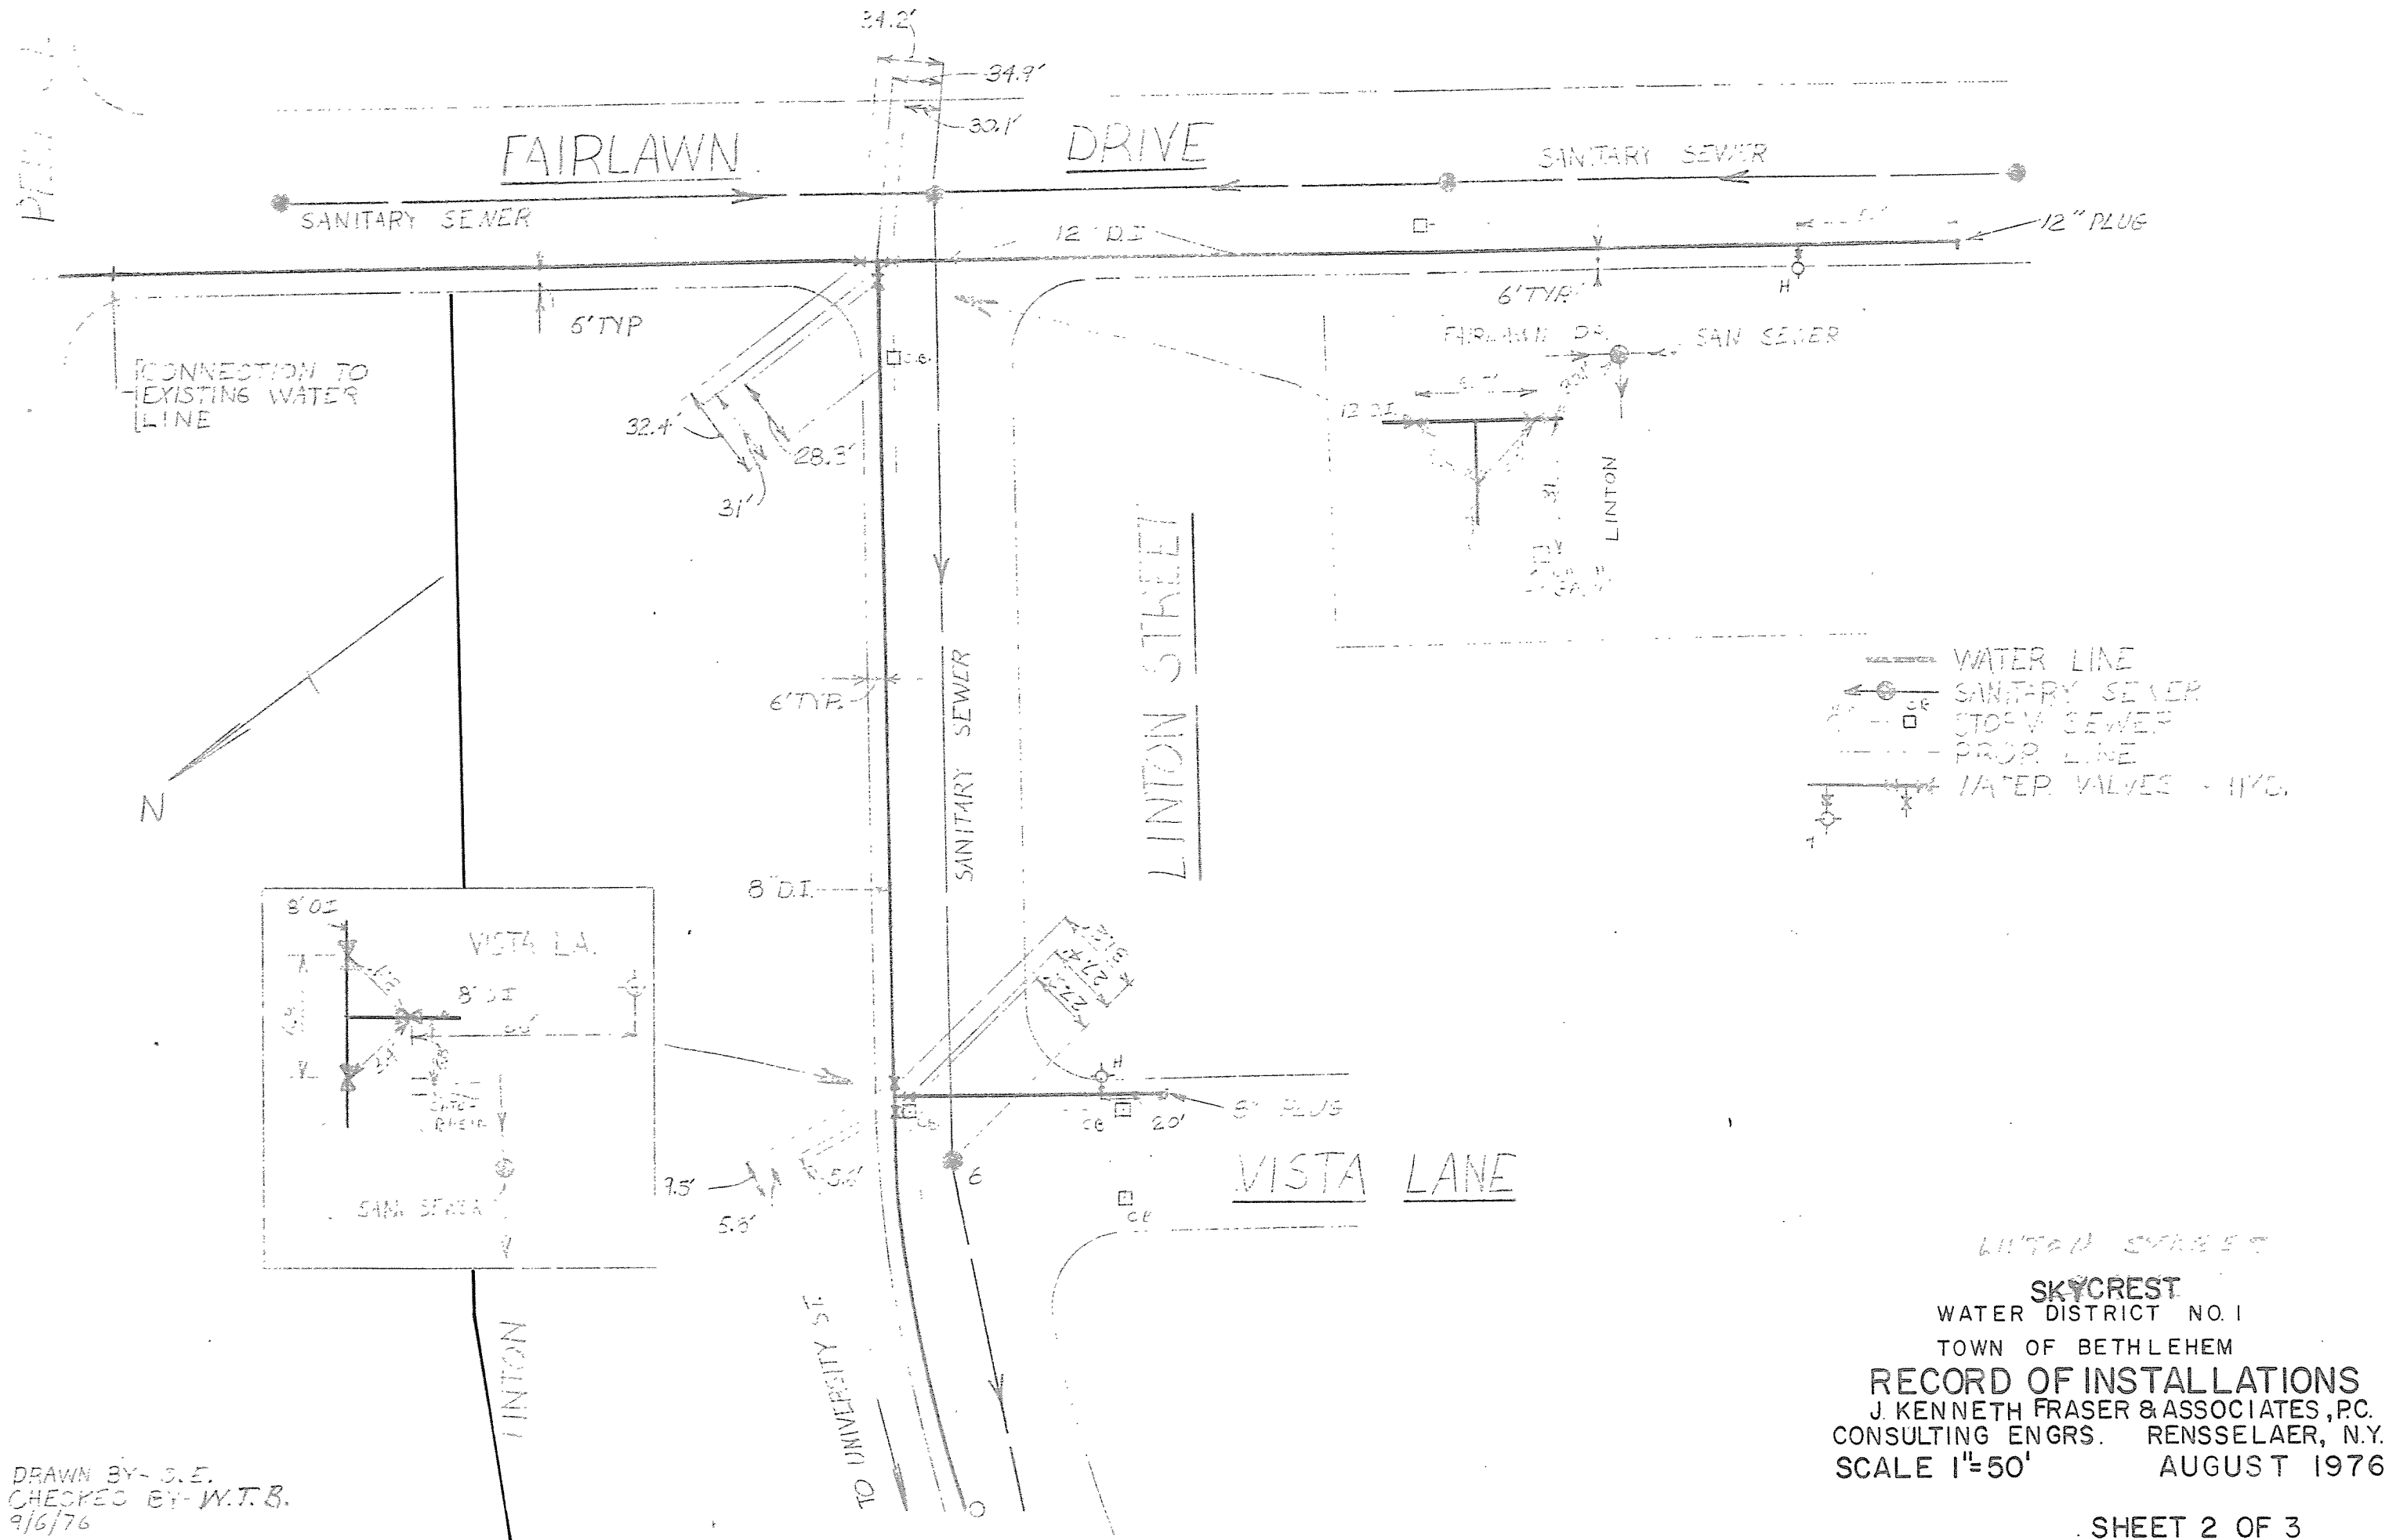

DRAWN BY - D.E.
CHECKED BY - W.T.B.
9/6/76

SKYCREST
WATER DISTRICT NO. 1
TOWN OF BETHLEHEM
RECORD OF INSTALLATIONS
J. KENNETH FRASER & ASSOCIATES, P.C.
CONSULTING ENGRS. RENSSELAER, N.Y.
SCALE 1"=50' AUGUST 1976