


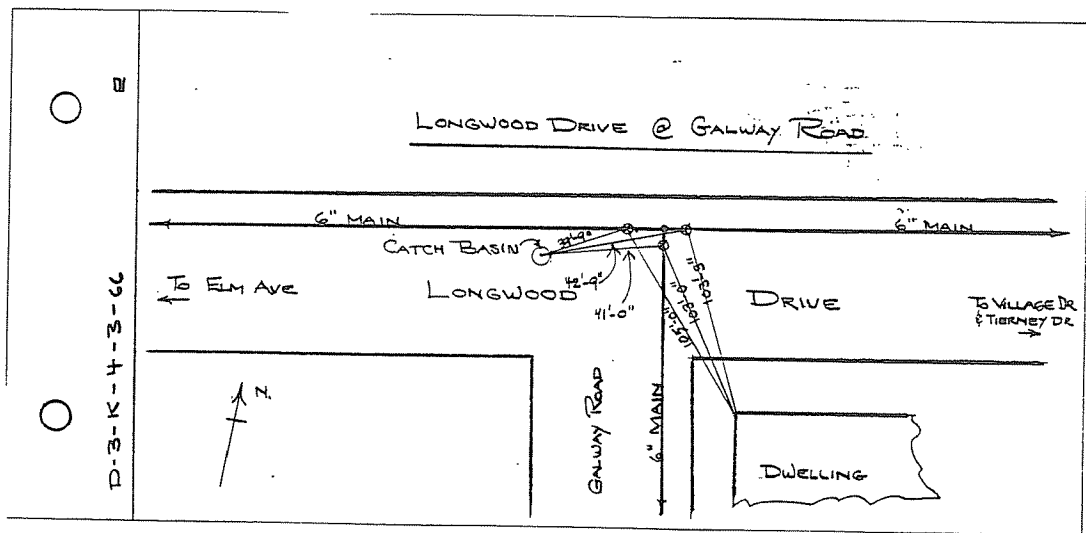

LONGWOOD DRIVE

WATER MAIN