

LOWER CORNING HILL
WATER EXT.

**TOWN OF BETHLEHEM
DEPARTMENT OF PUBLIC WORKS**


FEBRUARY 1982

**ENGINEERS - J. KENNETH FRASER &
ASSOCIATES, P.C.**


CONTRACTOR - AUGUST BOHL CONT.

INSPECTION - TOWN OF BETHLEHEM


SCALE 1" = 100'

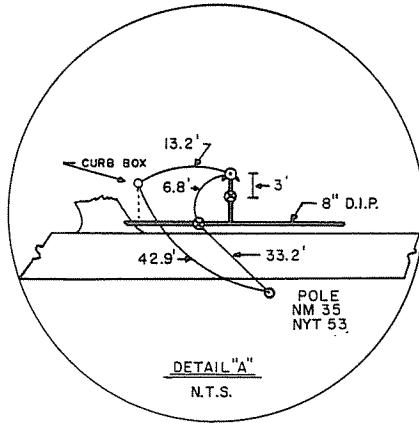

DETAIL "A"

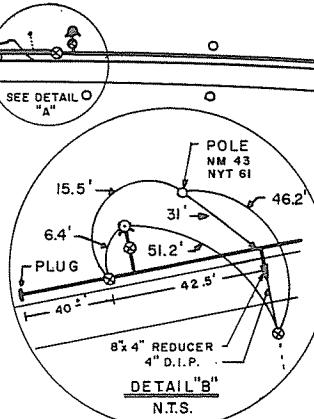

DETAIL

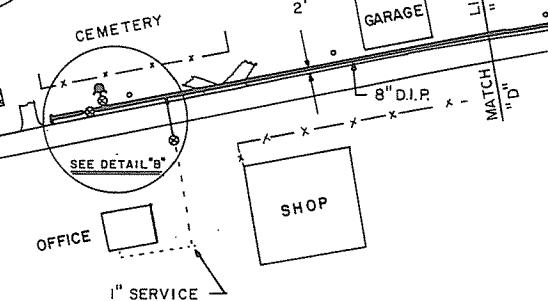

LEGEND.

- CATCH BASIN
- MANHOLE
- △ HYDRANT
- ◎ GATE VALVE
- TEE
- △ THRUST BLOCK
- WATER MAIN