

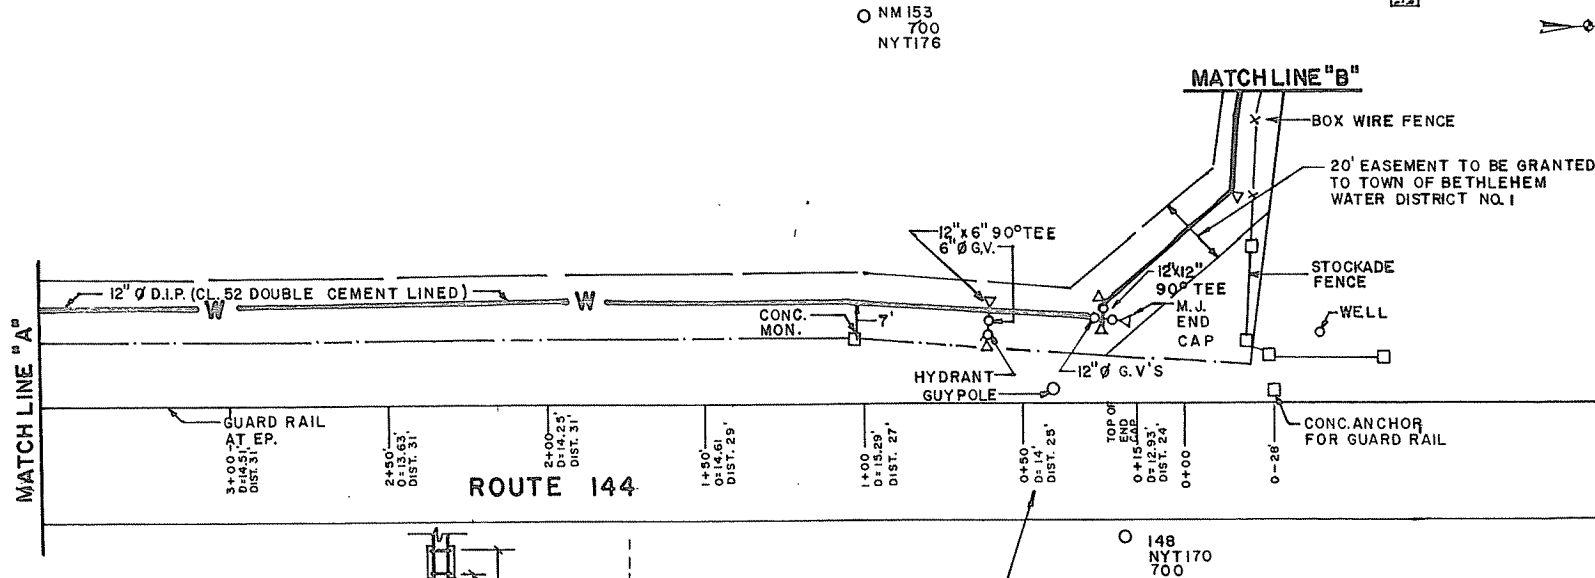


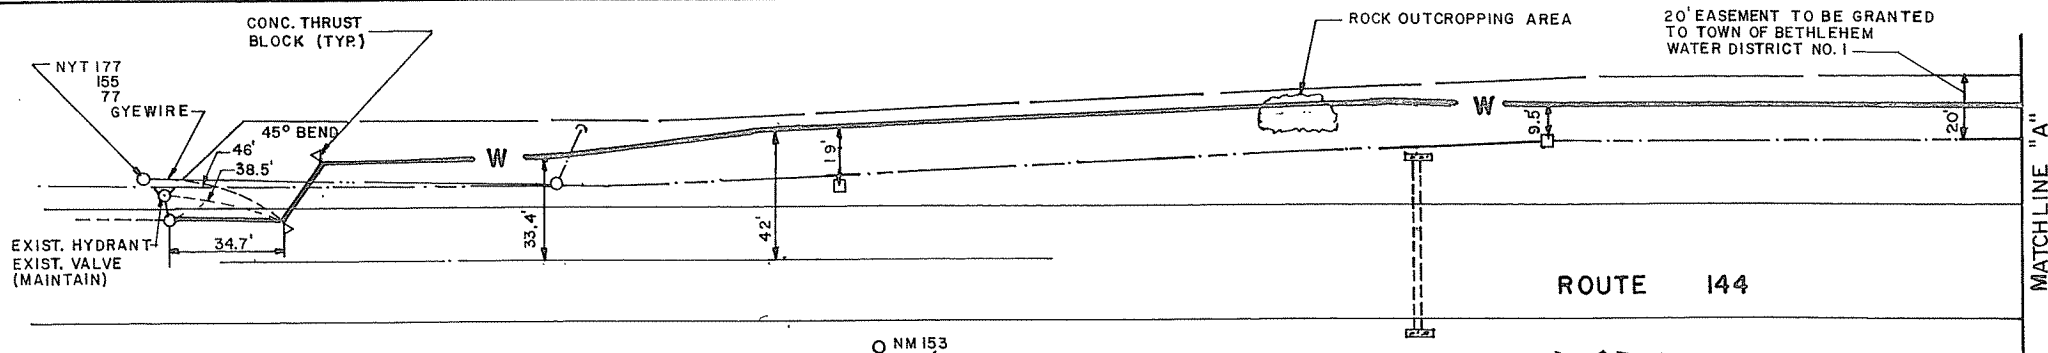

NOTE:

- 0+15 (STATION)
- D=12.93' (DIFFERENCE IN ELEVATION BETWEEN ζ OF ROUTE 144 & TOP OF 12" D.I.P.)
- DIST. 24' (DISTANCE FROM E/P TO ζ OF PIPE)

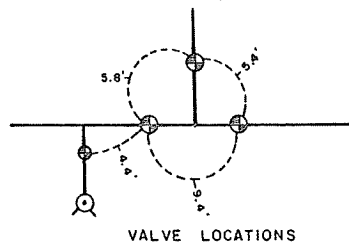

LOWER WEMPLE RD. WATER EXTENSION

APRIL 20, 1990
SCALE: 1"= 40'

RECORD
DRAWING

DRAWN BY: MG.
CHECKED BY: