



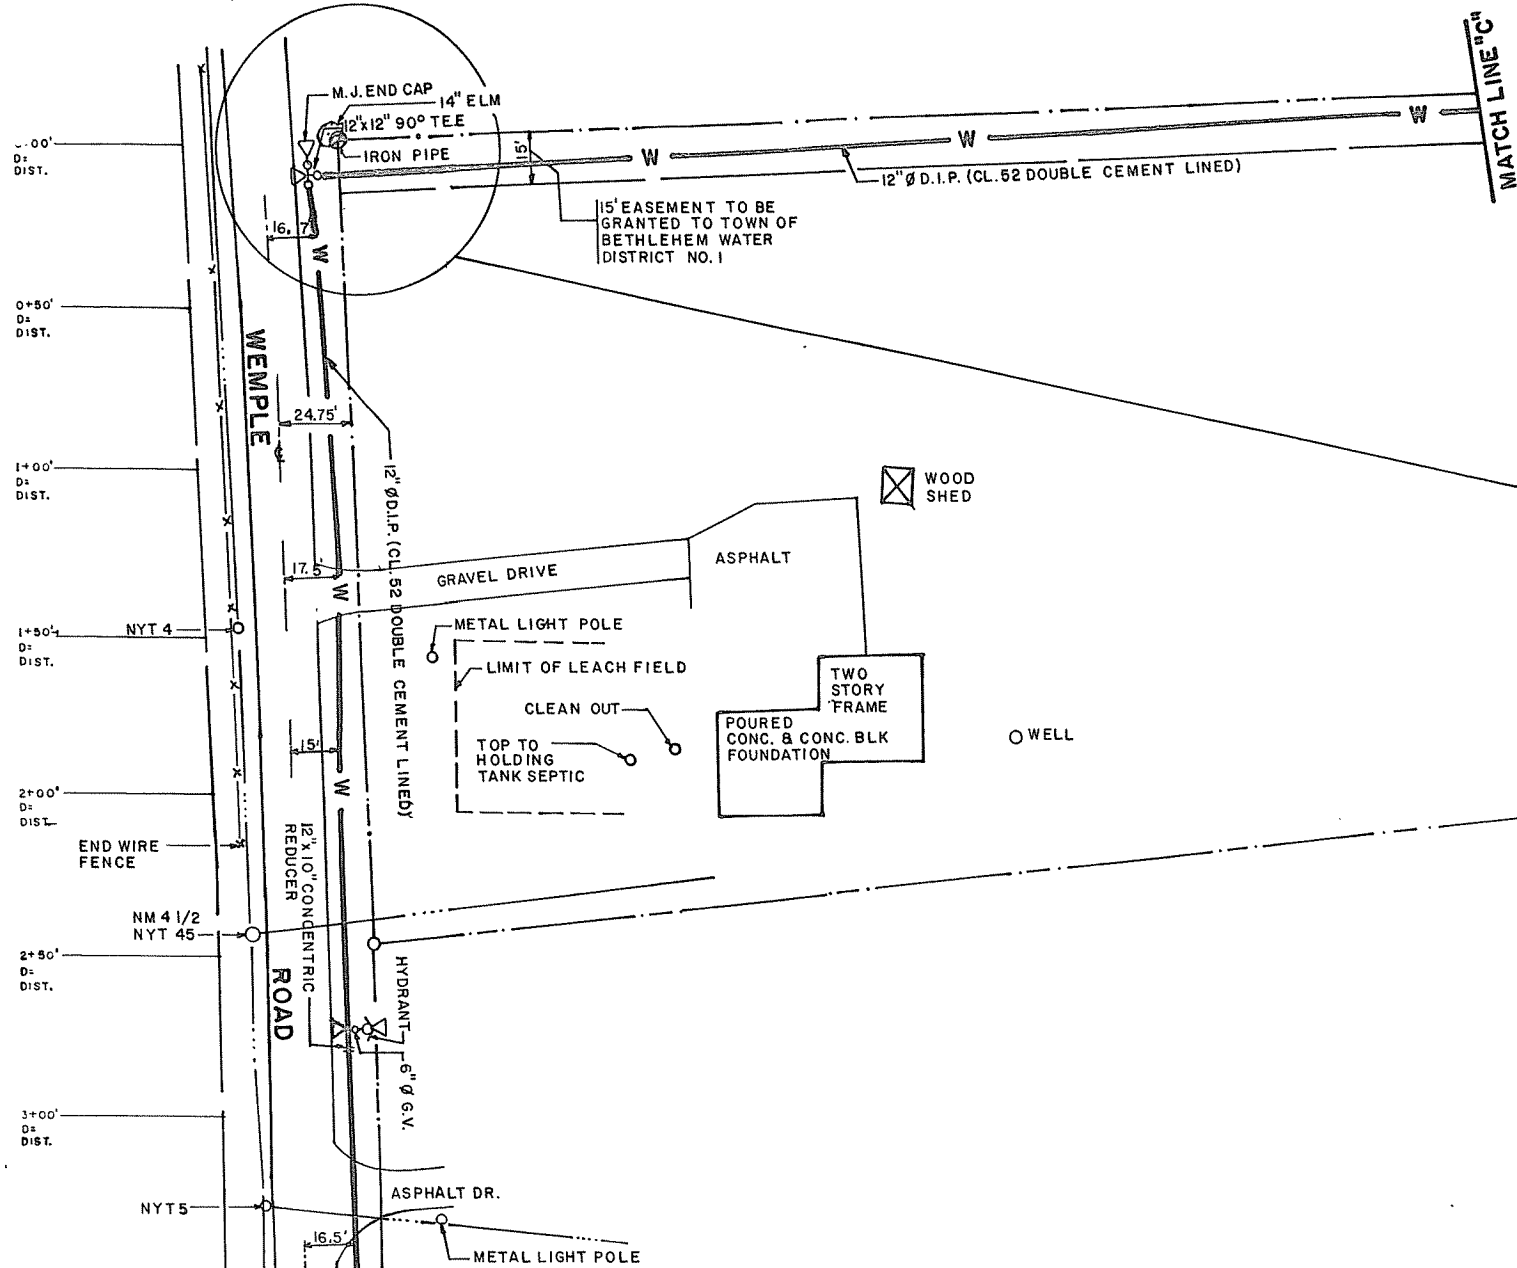

WEMPLE ROAD

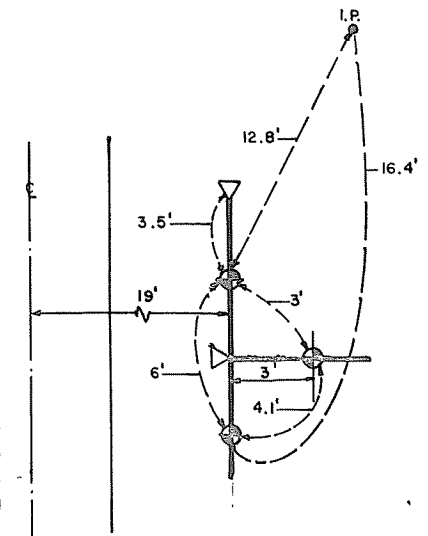

VALVE LOCATIONS
NTS

DRAWN BY: MG.
CHECKED BY:

MATCH LINE "D"

LOWER WEMPLE RD. WATER EXTENSION

APRIL 20, 1990
SCALE: 1" = 40'

RECORD
DRAWING